


A-41-Ax

A-41

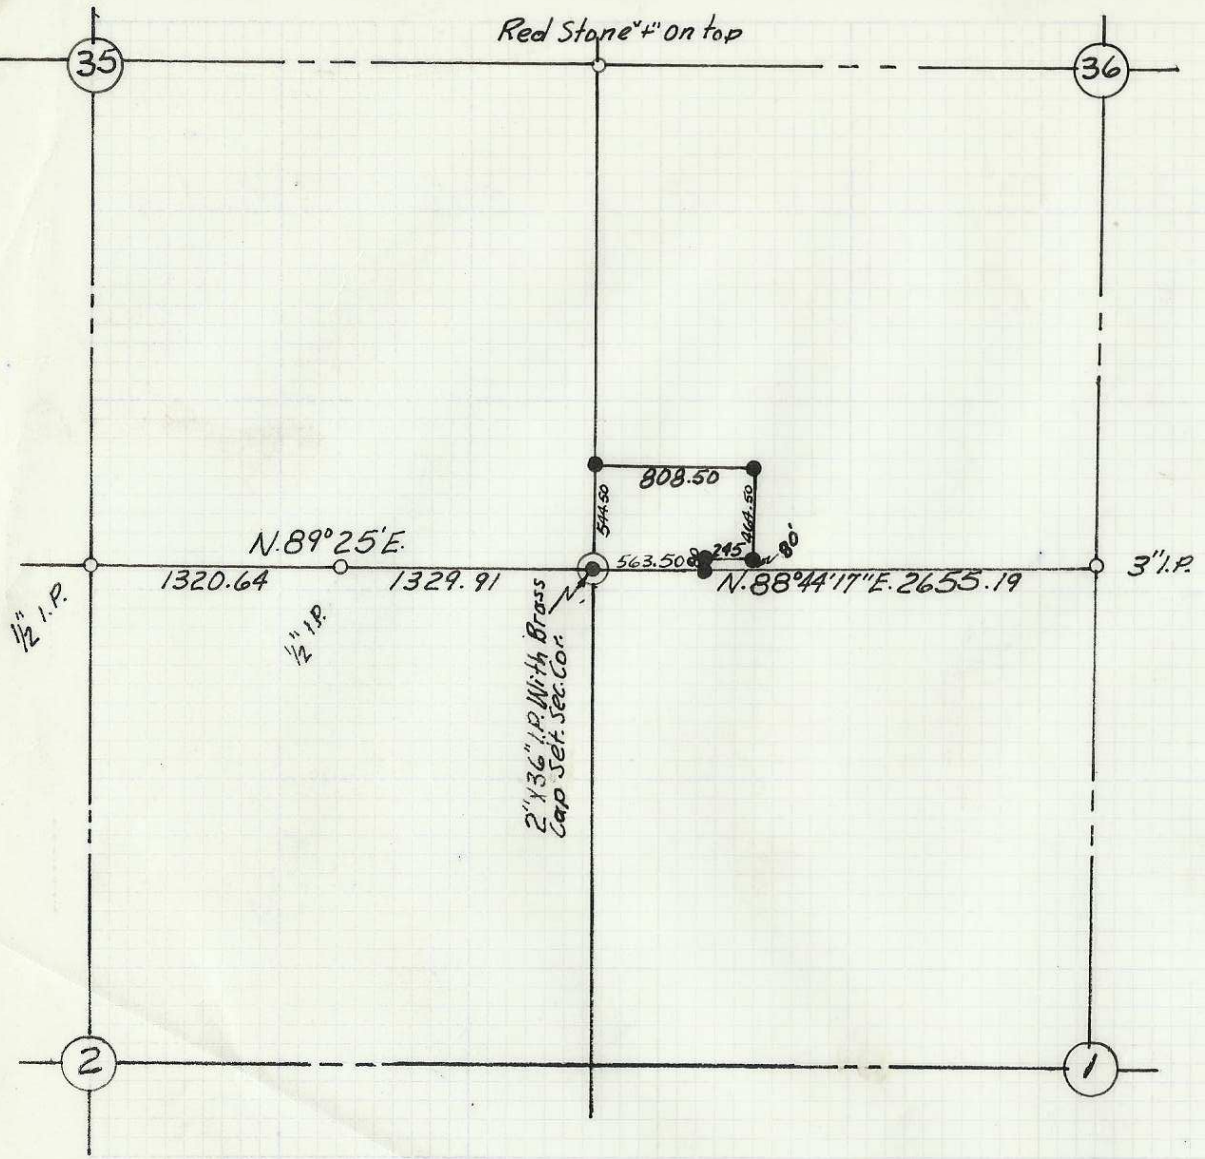

- Indicates Mon's Found
- Indicates Mon's Set
- Indicates Property Cor's Set

REGISTERED  
**OREGON**  
 LAND SURVEYOR

*Ralph P. Thompson*

MAY 13, 1960  
 RALPH P. THOMPSON  
 506

A-4L

Property Survey For  
**MORMON CHURCH**  
 In SW 1/4 Sec. 36, T. 6 N. R. 35 E. W. M.  
 Date: 12-65 | Scale: 1"=1000'

**R. P. THOMPSON**  
 REGISTERED PROFESSIONAL LAND SURVEYOR  
 13 S. E. COURT AVE, PENDELTON, OREGON

ALPINE STATE 10 5641 NON-PROF. 10 X 10 TO THE INCH