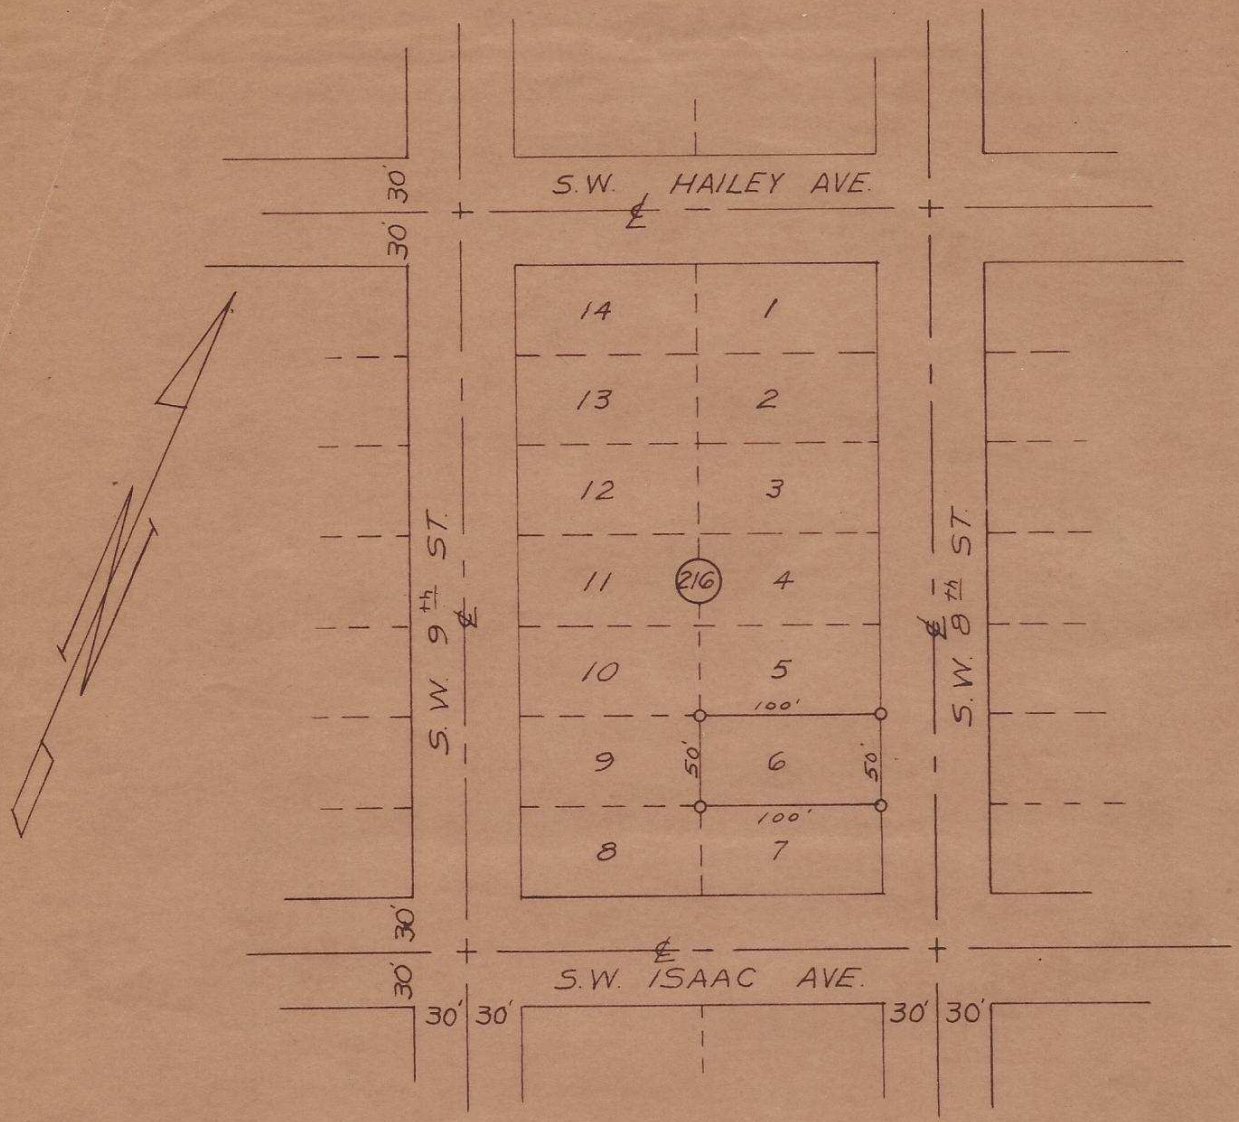

o Denotes 1/2" I. Pin Set

REGISTERED
OREGON
LAND SURVEYOR

Leland H. Ascher

JULY 10, 1964
LELAND H. ASCHER
635

WAYNE O. HARRIS & ASSOCIATES

SURVEY FOR

DELOY CHRISTIANSEN

LOT 6 BLOCK 216
RESERVATION ADDITION TO
PENDLETON, OREGON

SCALE	DATE	DRN. BY	DRNG. NO.
1"-100'	9-3-65	LHA	65-218

A-62-A x A-62 ~~A-35~~