


F-18-Ax

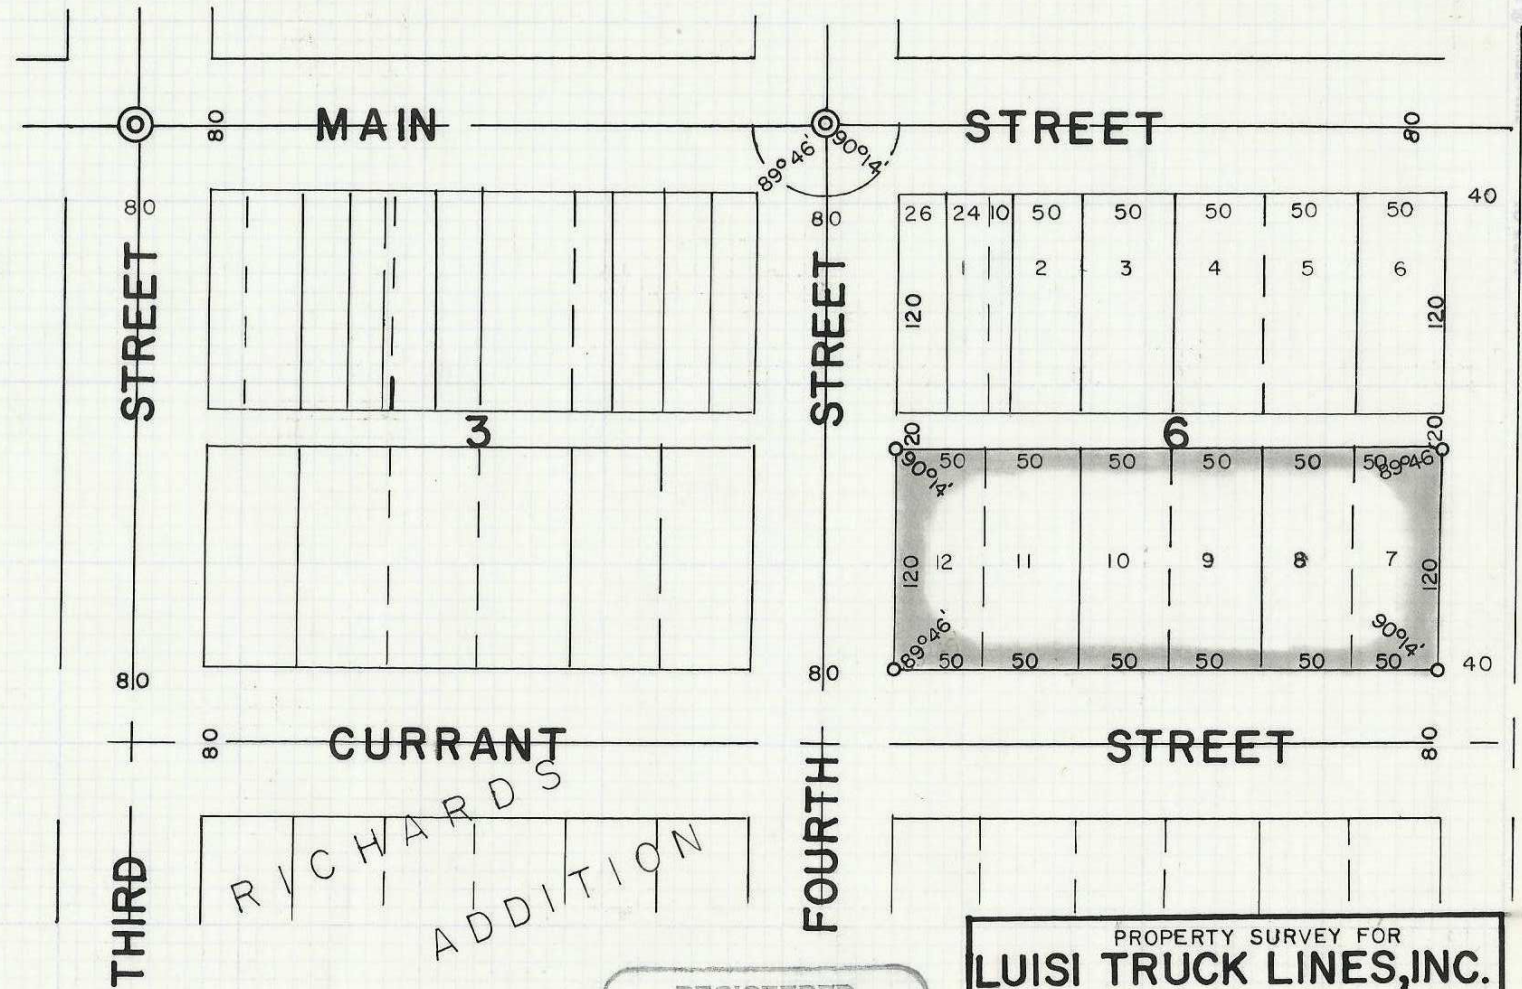

"O" INDICATES IRON PIN SET.  
 "⊙" INDICATES MONUMENT FOUND.

REGISTERED  
**OREGON**  
 LAND SURVEYOR

*Ralph P. Thompson*

MAY 13, 1960  
 RALPH P. THOMPSON  
 508

PROPERTY SURVEY FOR  
**LUISI TRUCK LINES, INC.**  
 LOTS 7,8,9,10,11,12 BLK. 6, RICHARD'S ADDITION  
 ATHENA OREGON

DATE: 5-19-69      SCALE: 1" = 100'

**RALPH THOMPSON**  
 REGISTERED LAND SURVEYOR  
 P. O. BOX 1082    PENDLETON, ORE. 97801

1/4 NE 1/4 SW 1/4 Sec. 19, T4N R35

F-18