

FD. STONE WITH CROSS ON TOP
2 SLASHES ON SOUTH SIDE
AGREES WITH BRG. TREE
S 12° E 13.9 FT.

(80.24 CHAINS) (80.00 CHAINS) (N 89° 39' W 39.96 CHAINS)
24 19 5291.94 19 20 N 88° 47' 17" W 2,635.36
25 30 30 29 1317.68 1317.68

SET 2" GALV. PIPE BY
DOUBLE PROPORTIONATE
DISTANCE.
SCRIBED NEW BRG. TREES
12" PINE N 16° E 29.3 FT.
36" PINE S 71° E 33.2 FT.
18" PINE S 62° W 62.1 FT.

FD. 2" PIPE
SCRIBED NEW BRG. TREES
12" TAMARACK N 26° E 25.7 FT.
14" FIR S 47° E 43.7 FT.

NOTE: BEARINGS AND DISTANCES ALONG
SECTION LINES SHOWN IN PARENTHESES
ARE FROM ORIGINAL GOVERNMENT
SURVEY PERFORMED IN OCTOBER, 1866
BEARING BASE - BEARING OF HWY.
AS FOUND ON R/W MAPS.

(NORTH 80.00 CHAINS)
N 00° 34' 15" W 5,262.27

N 00° 19' 09" W 5,236.19

N 00° 03' 55" W 5,210.22

HWY. ϕ CURVE DATA

2° 18' C.L.
T Δ = 45° 56' 30"
T s = 1282.30'
450 SPIRALS
S = 5° 10' 30"
L.C.S. = 449.84

SET CENTER PUNCHED
R/R SPIKE
561° 11' 30" E
APPROX. 1/2 MILE
SET CENTER PUNCHED
R/R SPIKE 16.77
N 61° 11' 30" W FROM
 ϕ SPIRAL P.T.S.

SET CENTER
PUNCHED R/R SPIKE
1088.32

SET CENTER PUNCHED
R/R SPIKE

SET CENTER PUNCHED
R/R SPIKE

SET CENTER PUNCHED
R/R SPIKE


1294.13 1294.14
N 89° 54' 45" W 2,588.27
(N 89° 37' W 39.96 CHAINS)

SET 5/8" x 30" IRON PIN FOR CORNER
REESTABLISHED FROM HWY. FIELD
NOTES (7' OPPOSITE STA. 636+33)
SCRIBED NEW BRG. TREES

14" TAMARACK N 35° E 55.2 FT.
30" SPRUCE S 81° W 63.4 FT.

FD. 4" x 6" STONE
SCRIBED NEW BRG. TREES
12" TAMARACK S 03° W 27.1 FT.
12" TAMARACK N 84° 30' W 32.1 FT.

SET CENTER PUNCHED R/R
SPIKE AT ϕ SPIRAL P. S.T.
STA. 638+93.8

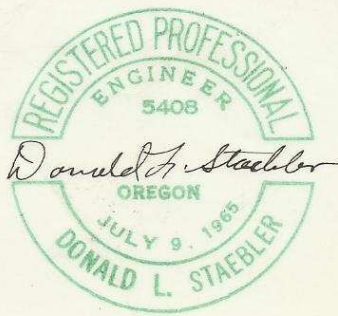

PROPERTY SURVEY

CONTROL SURVEY FOR
MOUNTAIN MEADOWS SUB-
DIVISION IN WEST HALF OF
SECTION 29, T4N, R37E, W.M.
FOR: OUTDOOR LIVING INC.

DR. BY: KWC DATE: 8-18-69 SCALE: 1"=1000'
CH. BY: DLS REV: SHEET 1 OF 1

DONALD L. STAEBLER
CONSULTING ENGINEER
213 S.W. EMIGRANT
PO. BOX 91

PENDLETON OREGON