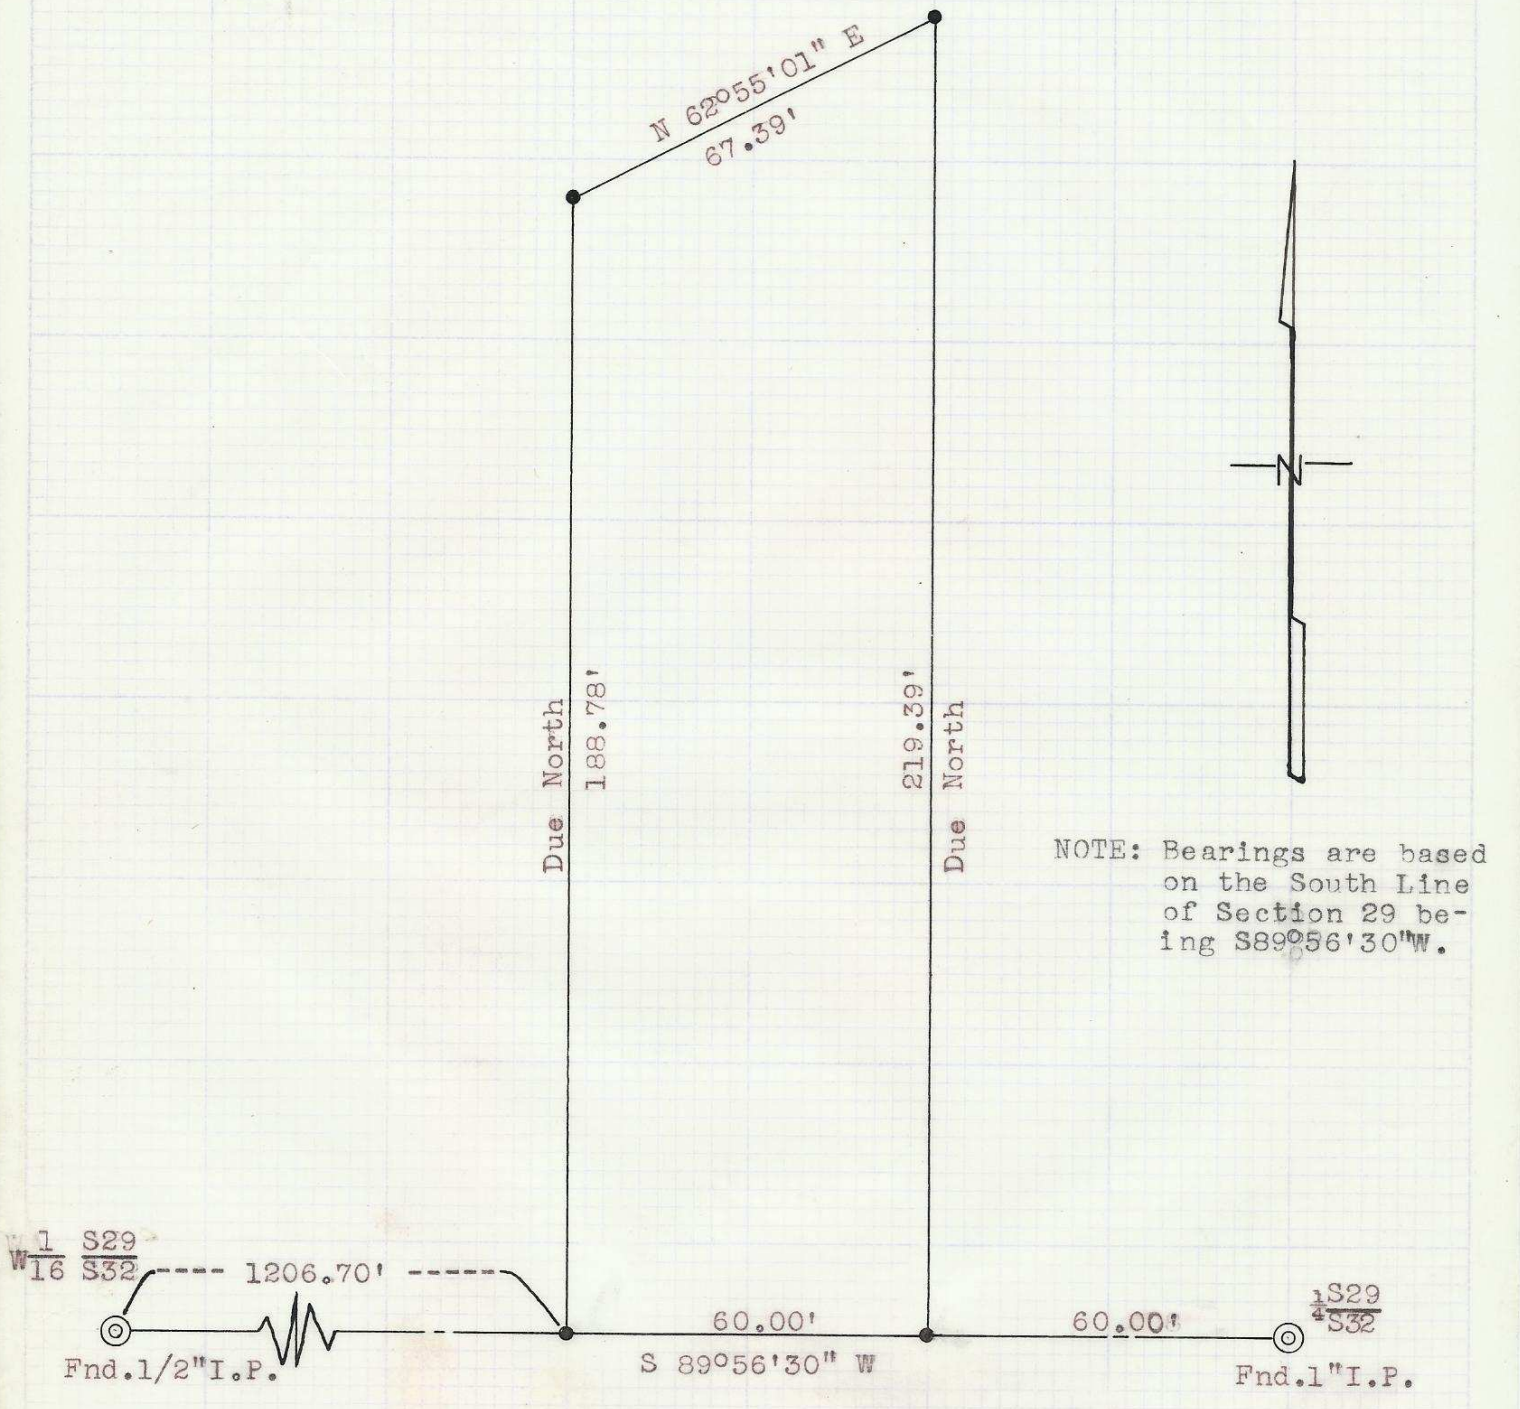

● 1/2" I.P.'s Set

◎ Monuments Found

REGISTERED
OREGON
LAND SURVEYOR

Ralph P. Thompson

MAY 13, 1960
RALPH P. THOMPSON
506

PROPERTY SURVEY for
H.H. KIRK
in the
SE¼, SW¼, Sec. 29, T3S, R31E.W.M.

Scale: 1"=30' | Date: 9-2-69

RALPH THOMPSON
REGISTERED LAND SURVEYOR
P. O. BOX 1082 · PENDLETON, ORE. 97801

H-27-A x