



H-194-Ax

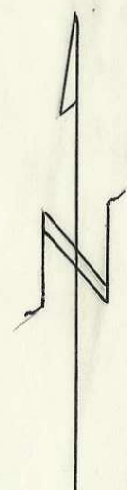

Points found as noted ●
 Points set as noted ○
 Bearings as used in property description

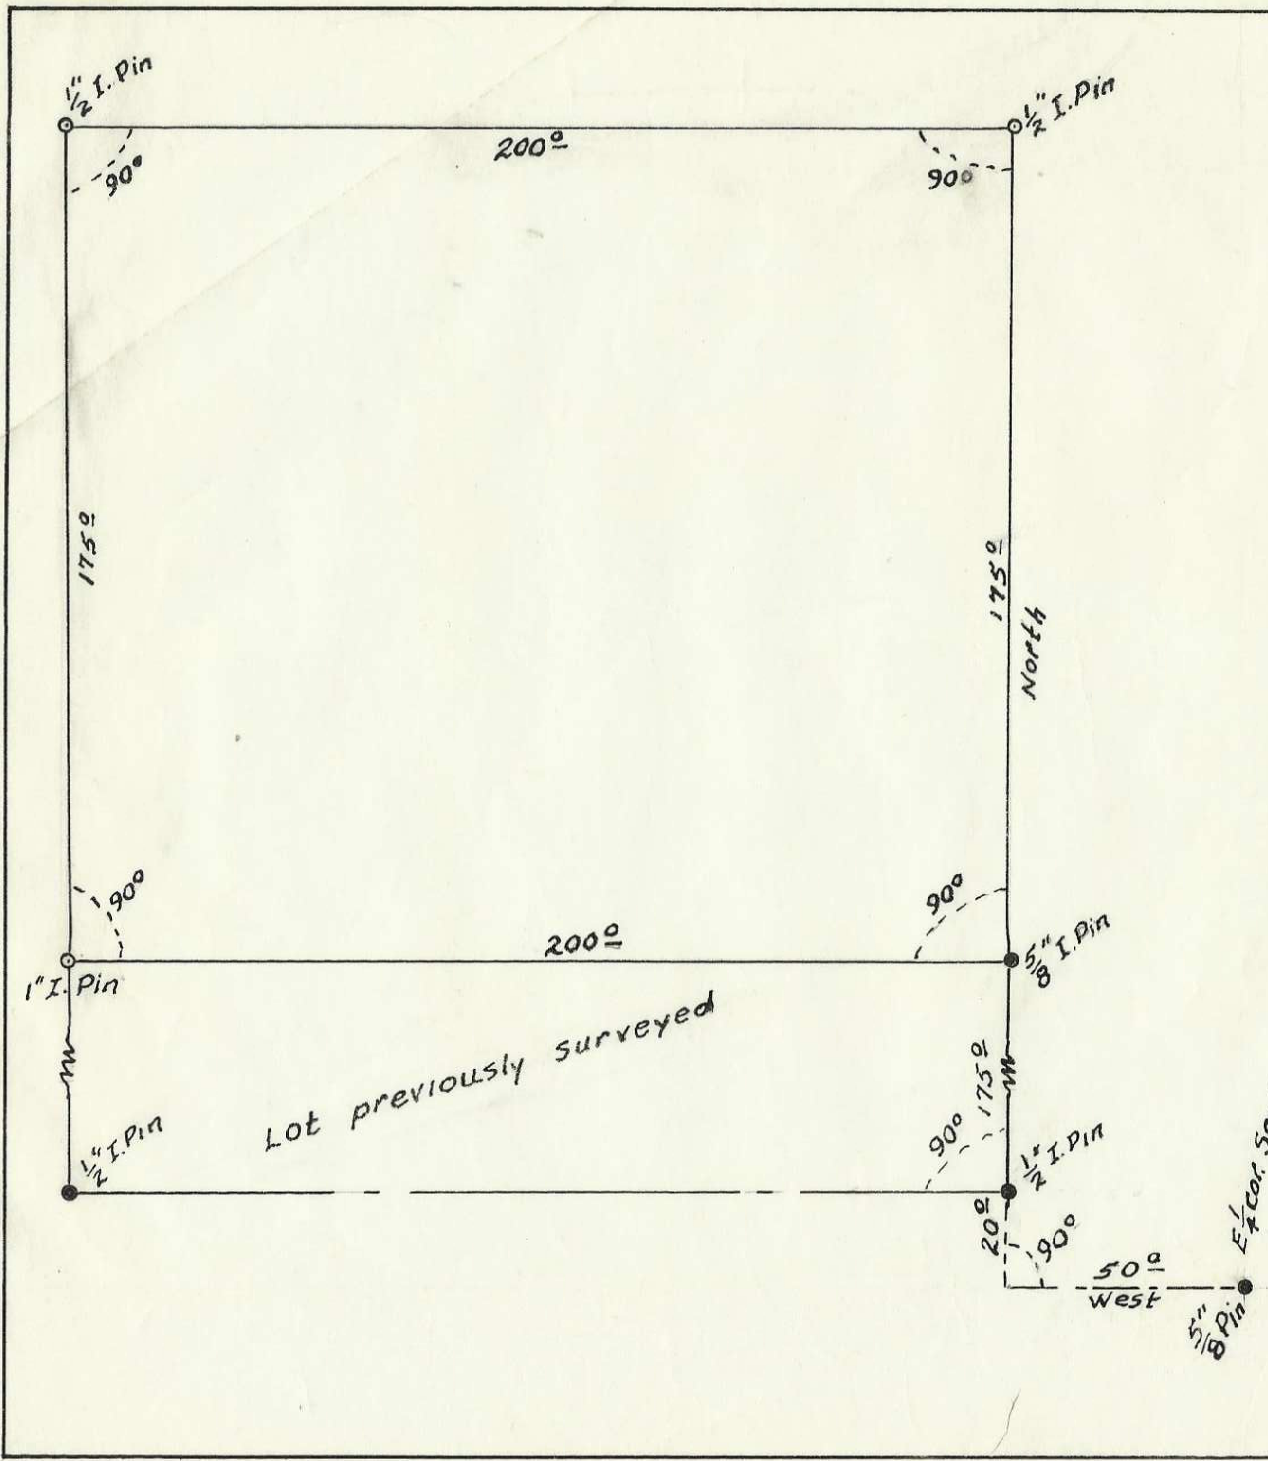

PLOT PLAN
 LOT IN NE 1/4 SECTION 3
 T4N., R28E., W.M.
 UMATILLA CO. OREGON
 SCALE 1"=40' 2-28-73
 FOR JOE BURKHALTER

H-194