


LOT 8
24.30 ac. net
25.65 gr.

LOT 9
19.05 ac. net
20.40 gr.

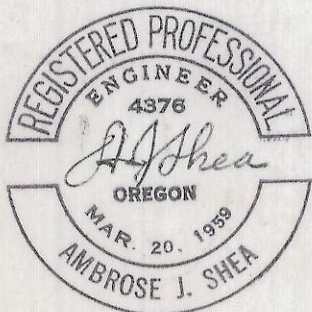

Legend

- Points Found
- Points Set

Bearings based on Survey of Sec. 3 by
by Government Surveyor, W. Roy Saxton
March, 1909. Files in Co. Recorders Office.

PROPERTY SURVEY
FOR GOLDEN WEST CORP.
IN NW 1/4 OF SECTION 3
T 4 N, R 28 E, W.M.
UMATILLA COUNTY
Scale 1" = 300' 12-21-72