


H-244-AV

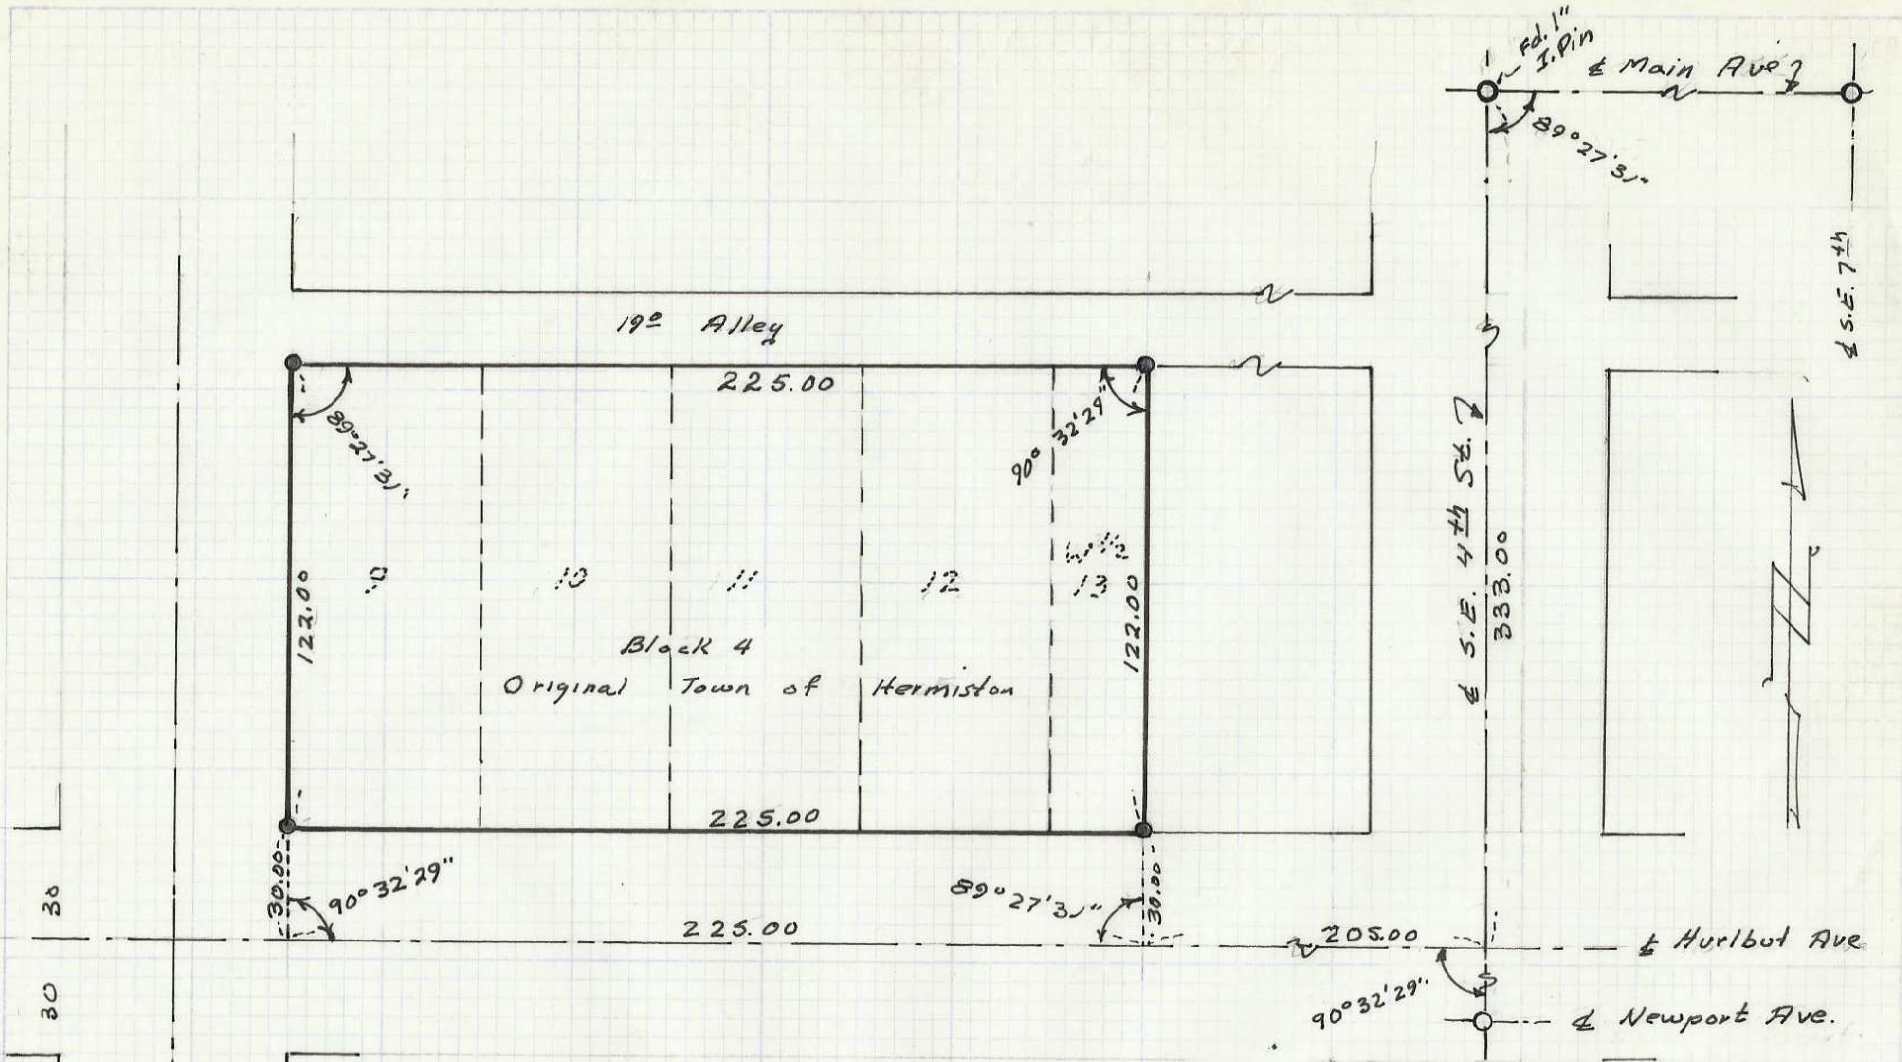

- LEGEND**
- Fd Iron Pipe Mon.
 - Set 1/2" x 24" Iron Pins

S.E. 3rd St.

**REGISTERED
PROFESSIONAL
LAND SURVEYOR**

Ralph P. Thompson

**OREGON
MAY 13, 1960
RALPH P. THOMPSON
506**

**SURVEY FOR
PACIFIC N.W. BELL TEL. CO.
OF
Lots 9, 10, 11, 12 & W^{1/2} of Lot 13, B1K 4,
ORIGINAL TOWN of HERMISTON, ORE.
Scale: 1" = 50' Date: 7-20-73**

RALPH THOMPSON
REGISTERED LAND SURVEYOR
P. O. BOX 1082 PENDLETON, ORE. 97801

H-244

ALWAYS USE SURVEY LINE 10 2041
NON-REPRODUCIBLE 10 X TO THE INCH