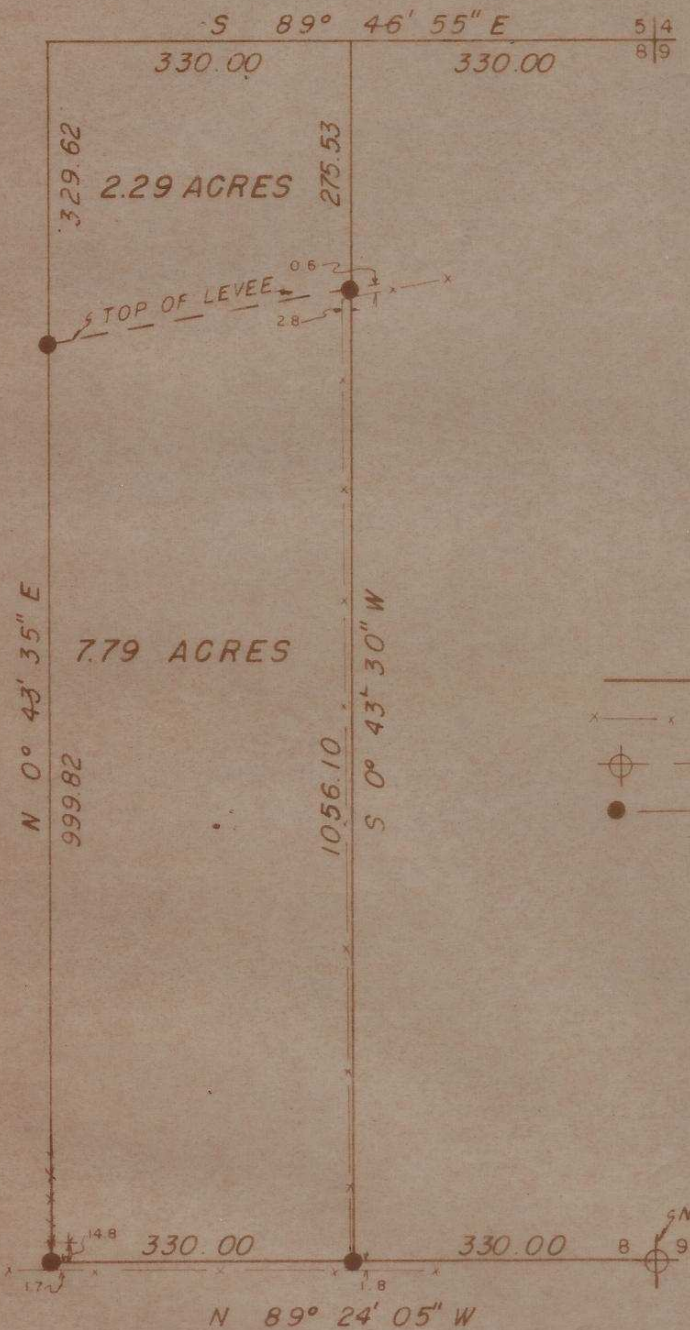

NOTE: BEARINGS ARE BASED ON TIES TO N.G.S STATION "MISSION". THE BEARINGS SHOWN ARE TRUE BEARINGS.

LEGEND

- FENCE
- BRASS CAP, FND.
- 5/8" IRON PIN, SET

REGISTERED PROFESSIONAL LAND SURVEYOR

David H. Kumbein

OREGON JULY 10, 1973 DAVID H. KUMBEIN 933

Survey For
WARREN MILLER

Parcel in NE1/4, NE1/4, Sec. 8, T.2N. R.33E.

WAYNE HARRIS CO. INC.

ENGINEERS - SURVEYORS PENDLETON OREGON

Scale	1"=200'	Drn. By	P.F.S	Drwg. No.
Date	1/23/75	Chkd. By	DHK	75-390

J-58-A