


LEGEND:
 □ POINTS FOUND AS DESCRIBED
 ○ POINTS SET AS DESCRIBED
 BEARINGS BASED ON ASSESSORS
 MAP OF THIS AREA 4N 2814

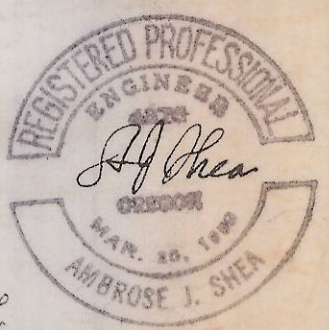

Amended 4/20/76 to
 show 35' Road from
 4th st. to E. 1/2 of
 property

K-3

FOR JAY WHEELHOUSE

PLAT OF SURVEY
 IN NW 1/4 SEC. 14, T4N, R28E, W.M.
 UMATILLA CO. ORE.
 SCALE 1" = 100' 12-15-75

K-3-Ax