


K-29-Ax

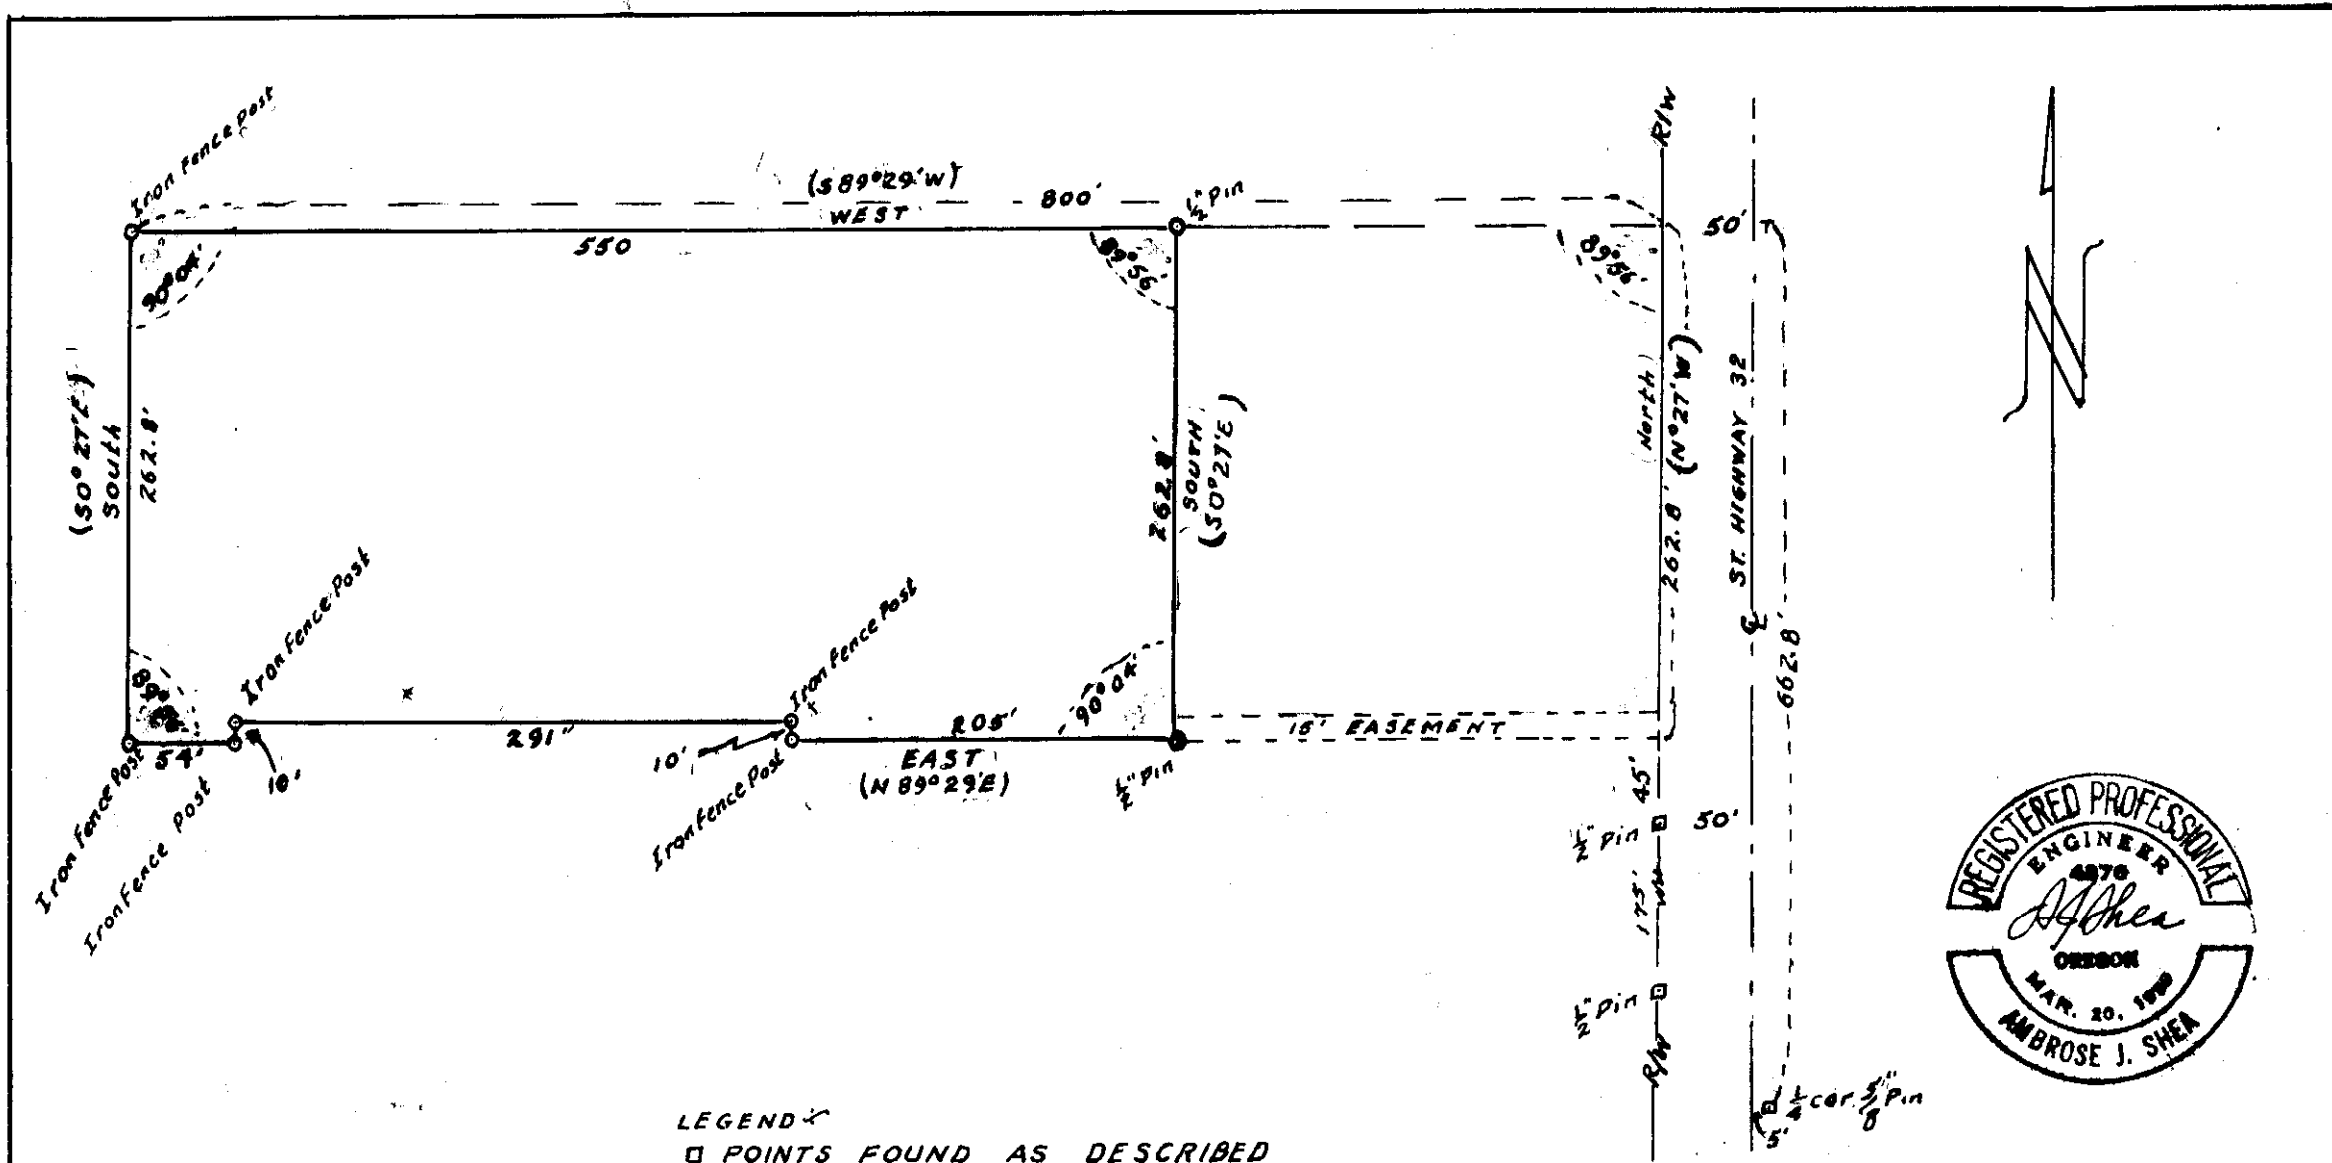

LEGEND
 □ POINTS FOUND AS DESCRIBED
 ● POINTS SET AS DESCRIBED
 (BEARINGS) IN ACCORDANCE WITH
 LEGAL DEED DESCRIPTION
 TRUE BEARINGS GIVEN IN BRACKETS



FOR VIRGIL RHINHART
 PLAT OF PROPERTY SURVEY
 IN SE 1/4 OF NE 1/4 SEC. 3, TAN, R28E, W.M.
 UMATILLA COUNTY
 SCALE 1" = 100' 1-17-76

K-29