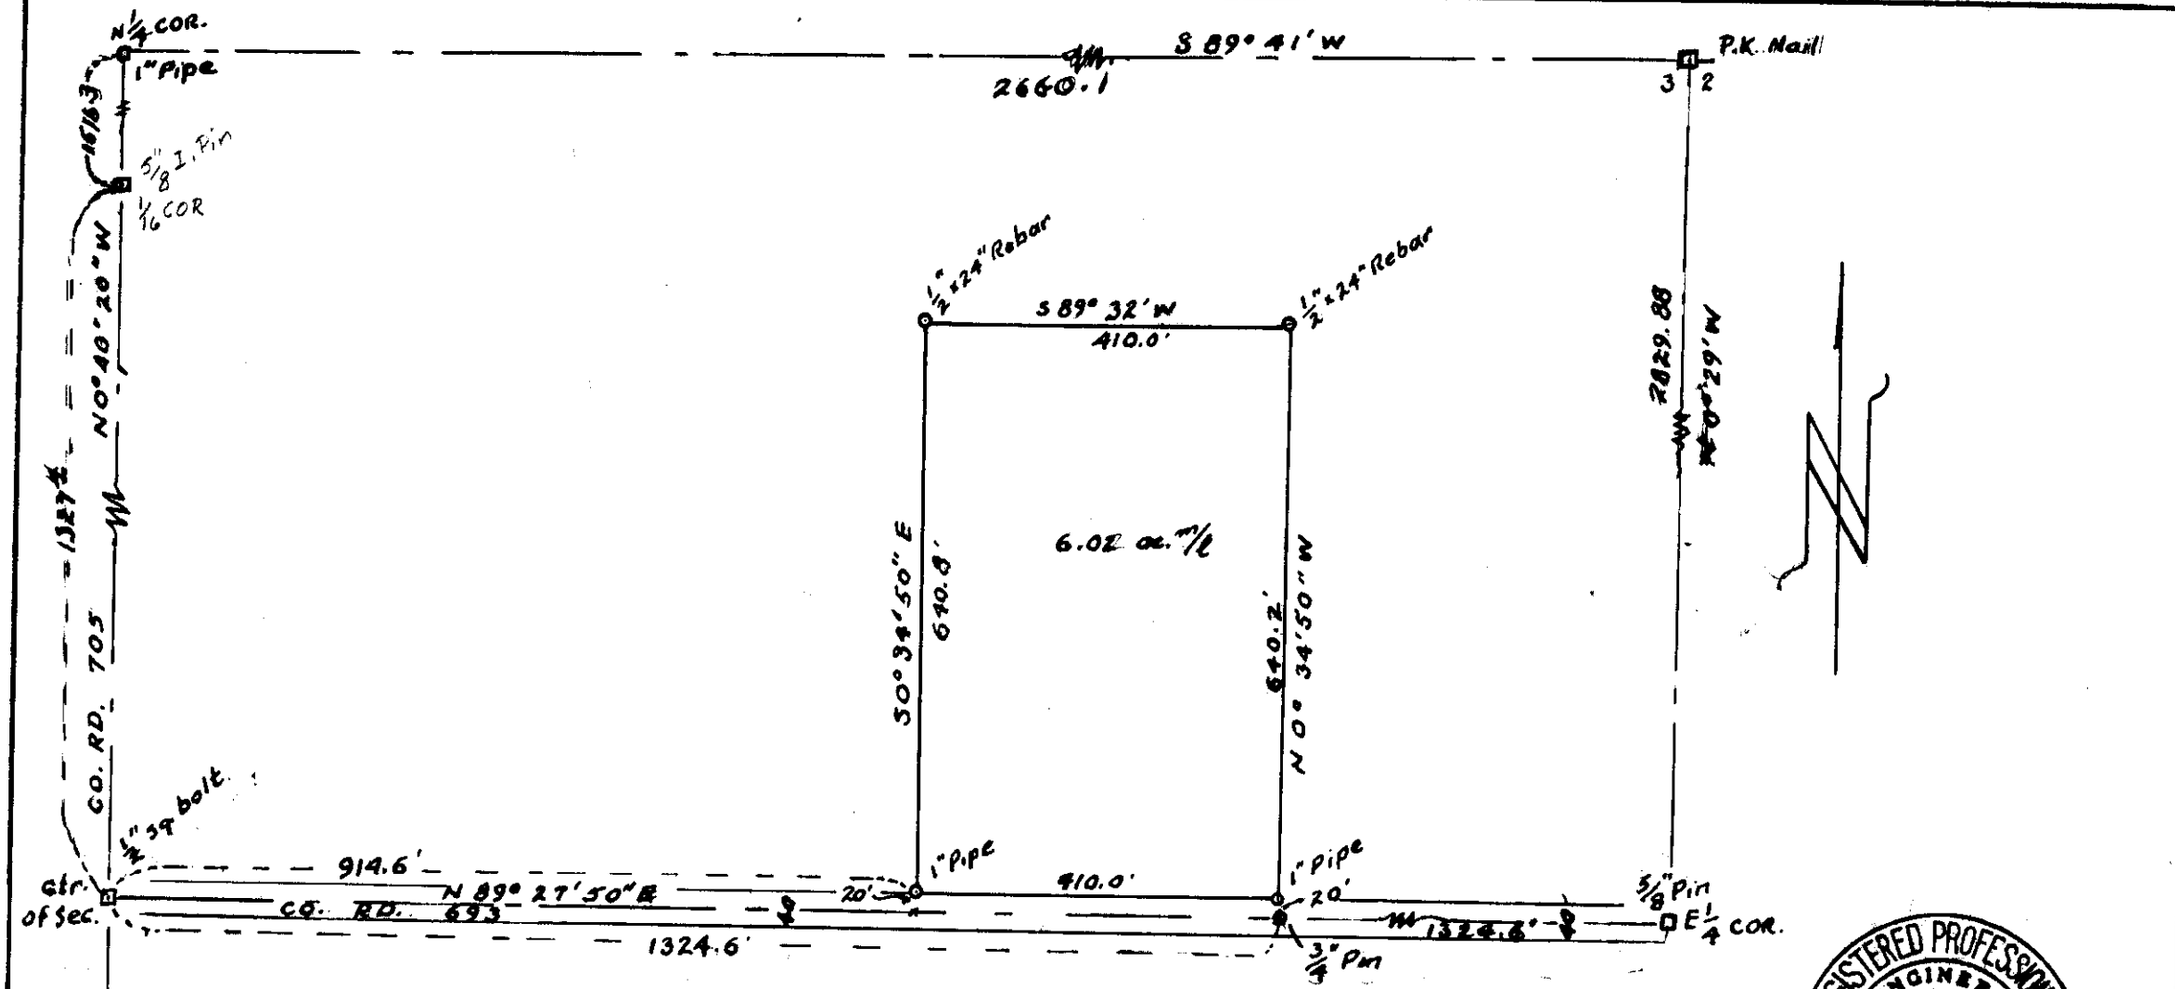

LEGEND :
□ POINTS FOUND
● POINTS SET AS DESCRIBED
BEARINGS BASED ON U.S.G.S. GRID
REFERRED TO STA. ON HERMISTON BUTTE

REGISTERED PROFESSIONAL ENGINEER 4376 OREGON MAR. 20, 1959 AMBROSE J. SHEA

K-82

FOR UNIVERSAL REALTY

PLAT OF SURVEY OF TRACT
IN NE 1/4 SEC 3, T 4 N R 28 E W.M.
UMATILLA CO. ORE.
SCALE 1" = 200' 5/3/76

K-82-A