
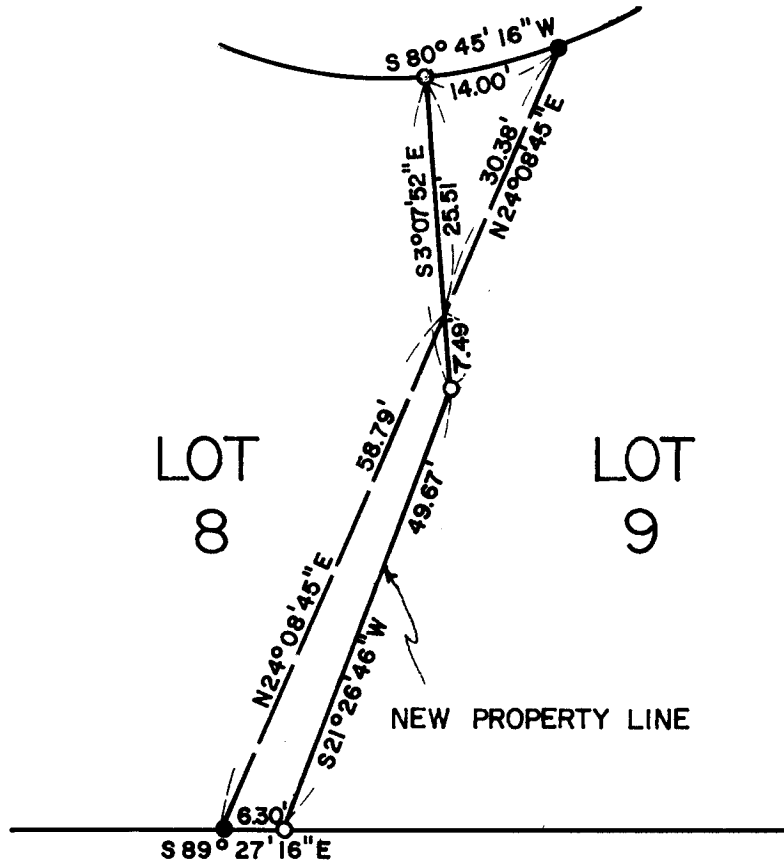


MCKENZIE AVENUE

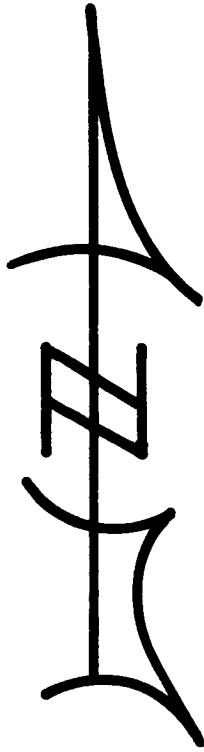

L-072-Ax

SURVEY FOR: PAUL WOLF

LOCATION: LOTS 8 & 9, BLOCK I, COTTONWOOD ESTATES
SEC. 14 , T 4 N, R 28 E, W.M., UMATILLA COUNTY, OREGON

DATE: 8-26-76

SCALE: 1" = 20'

● 1/2" I.R. MONUMENTS FOUND

(000) OF RECORD

○ 1/2" IRON RODS SET

JOB NO. S7607174

REGISTERED
PROFESSIONAL
LAND SURVEYOR

G. Dennis Edwards

OREGON
JULY 16, 1971
G. DENNIS EDWARDS
951

EDWARDS SURVEYING
567-3336

P. O. Box 763
Hermiston, Ore.