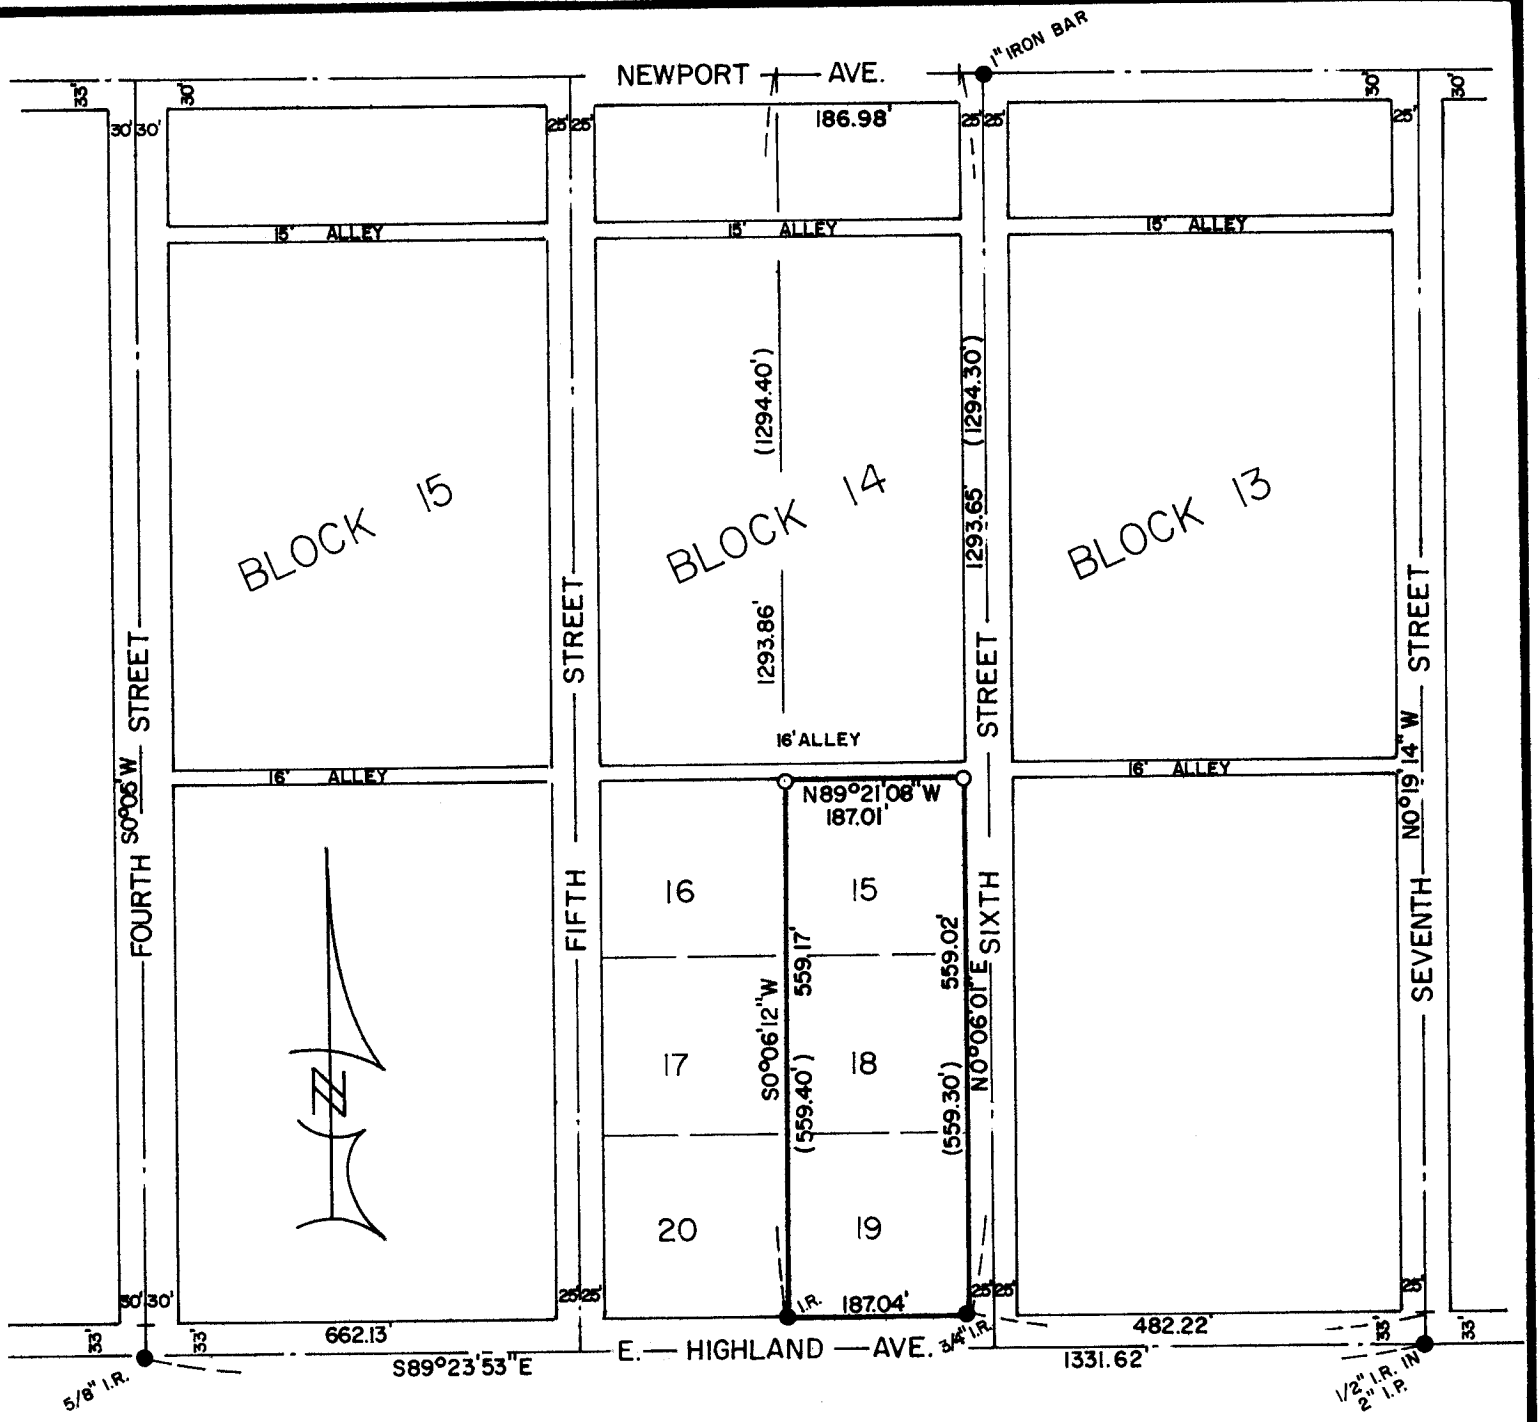

SURVEY FOR WALSH CONSTRUCTION

LOCATION LOTS 15,18 & 19, BLOCK 14, NEWPORT ADDITION TO THE CITY OF HERMISTON, IN THE SW 1/4 OF SEC. 11, T 4 N, R 28 E, W.M., UMATILLA COUNTY, OREGON

DATE: 4-22-77

SCALE: 1" = 200'

● MONUMENTS FOUND

(000) OF RECORD

o 1/2" IRON RODS SET

JOB NO. S7704117

REGISTERED PROFESSIONAL LAND SURVEYOR

G. Dennis Edwards

OREGON
JULY 16, 1971
G. DENNIS EDWARDS
951

M-085-AX

EDWARDS SURVEYING
567-3336

P. O. Box 763
Hermiston, Ore.