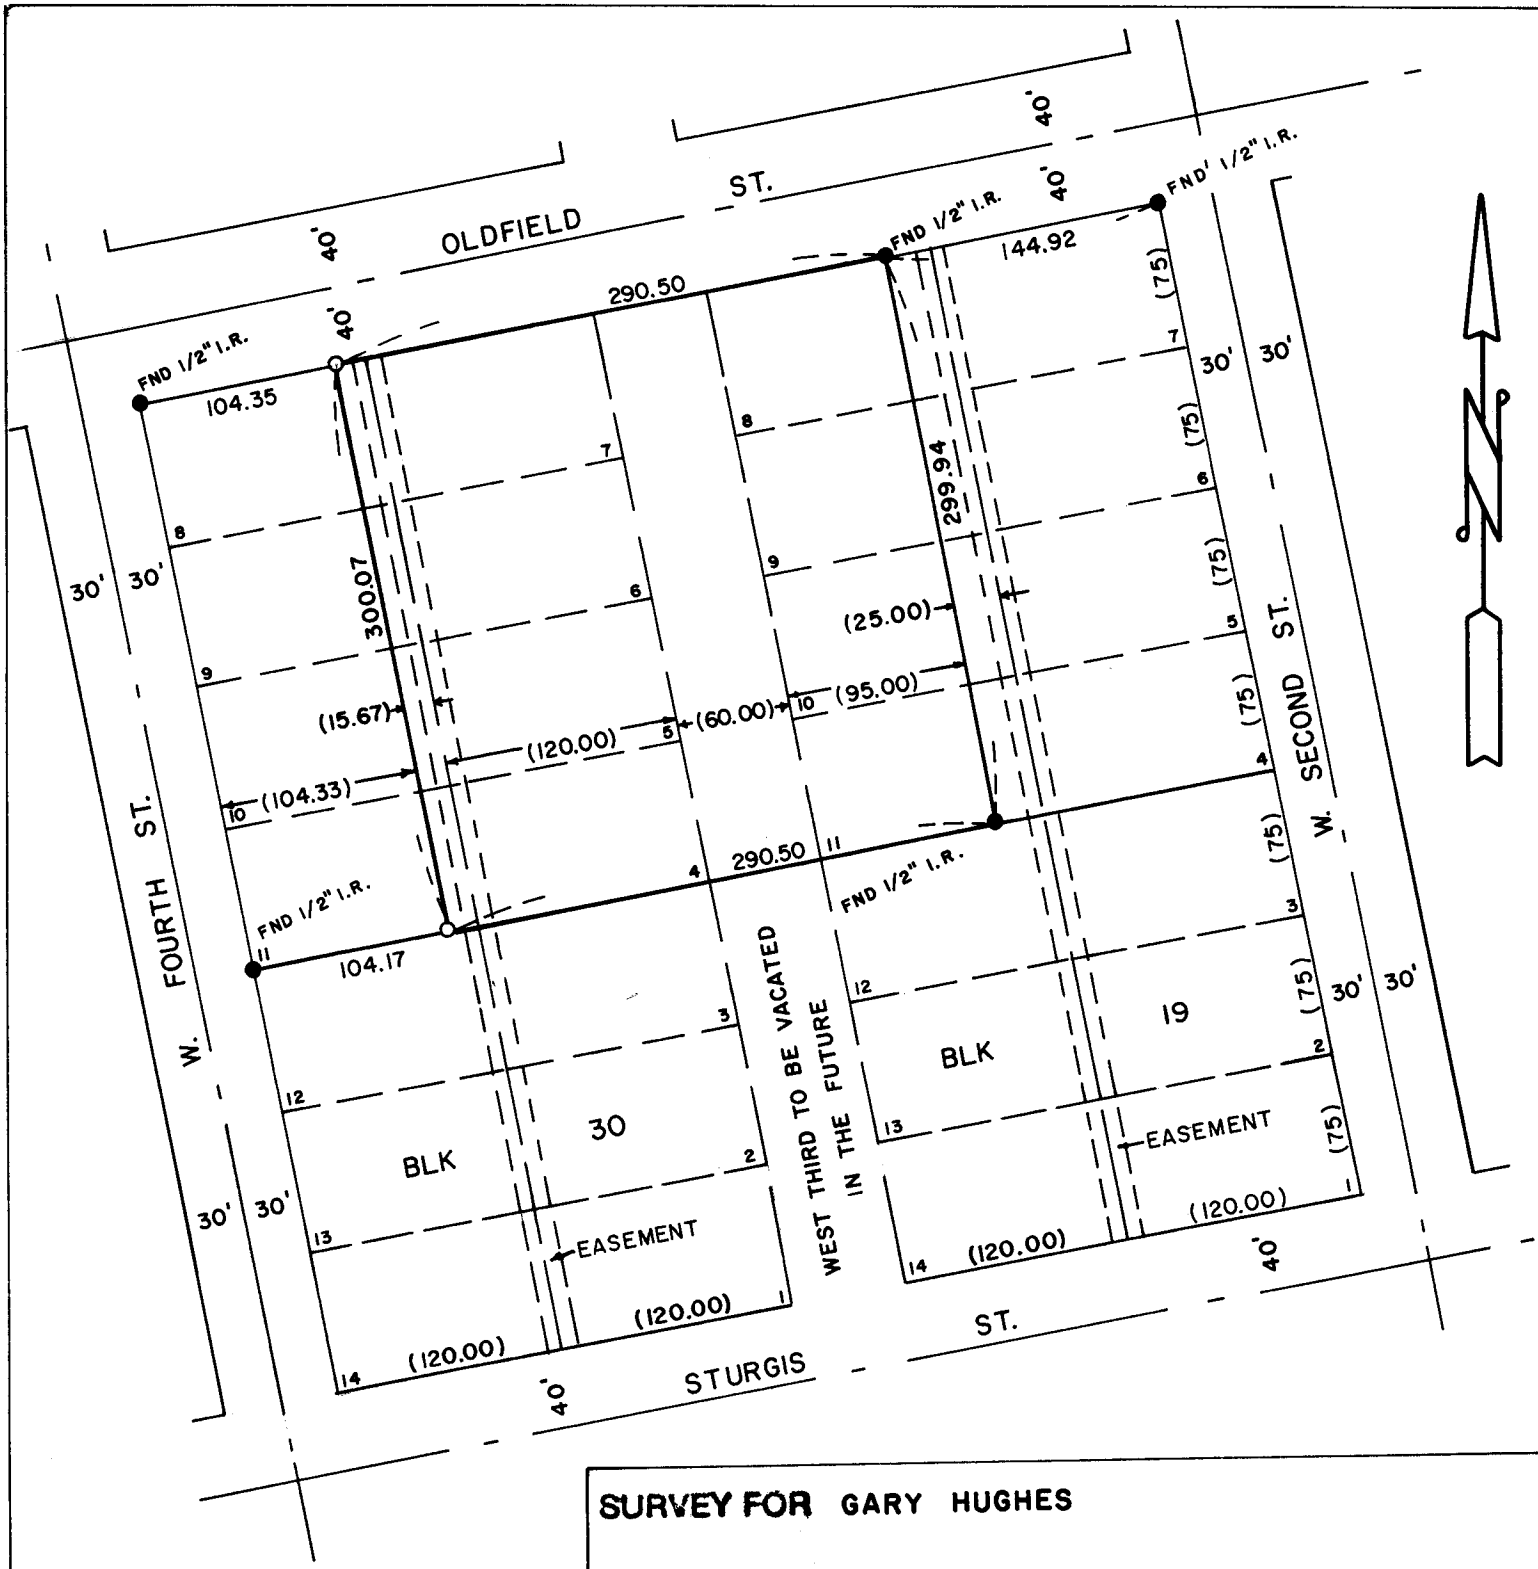

SURVEY FOR GARY HUGHES

LOCATION BLK 19 & 30, CHARLES TRACTS IN

SEC. 27, T 5 N, R 28 E, W.M., UMATILLA COUNTY, OREGON

DATE 4-26-78

SCALE: 1" = 100'

● MONUMENTS FOUND

(000) OF RECORD

○ IRON RODS SET 1/2"

JOB NO. S7802052-A

REGISTERED PROFESSIONAL LAND SURVEYOR

G. Dennis Edwards

OREGON
JULY 16, 1971
G. DENNIS EDWARDS
951

P-007-AX

EDWARDS SURVEYING
567-3336

P. O. Box 763
Hermiston, Ore.