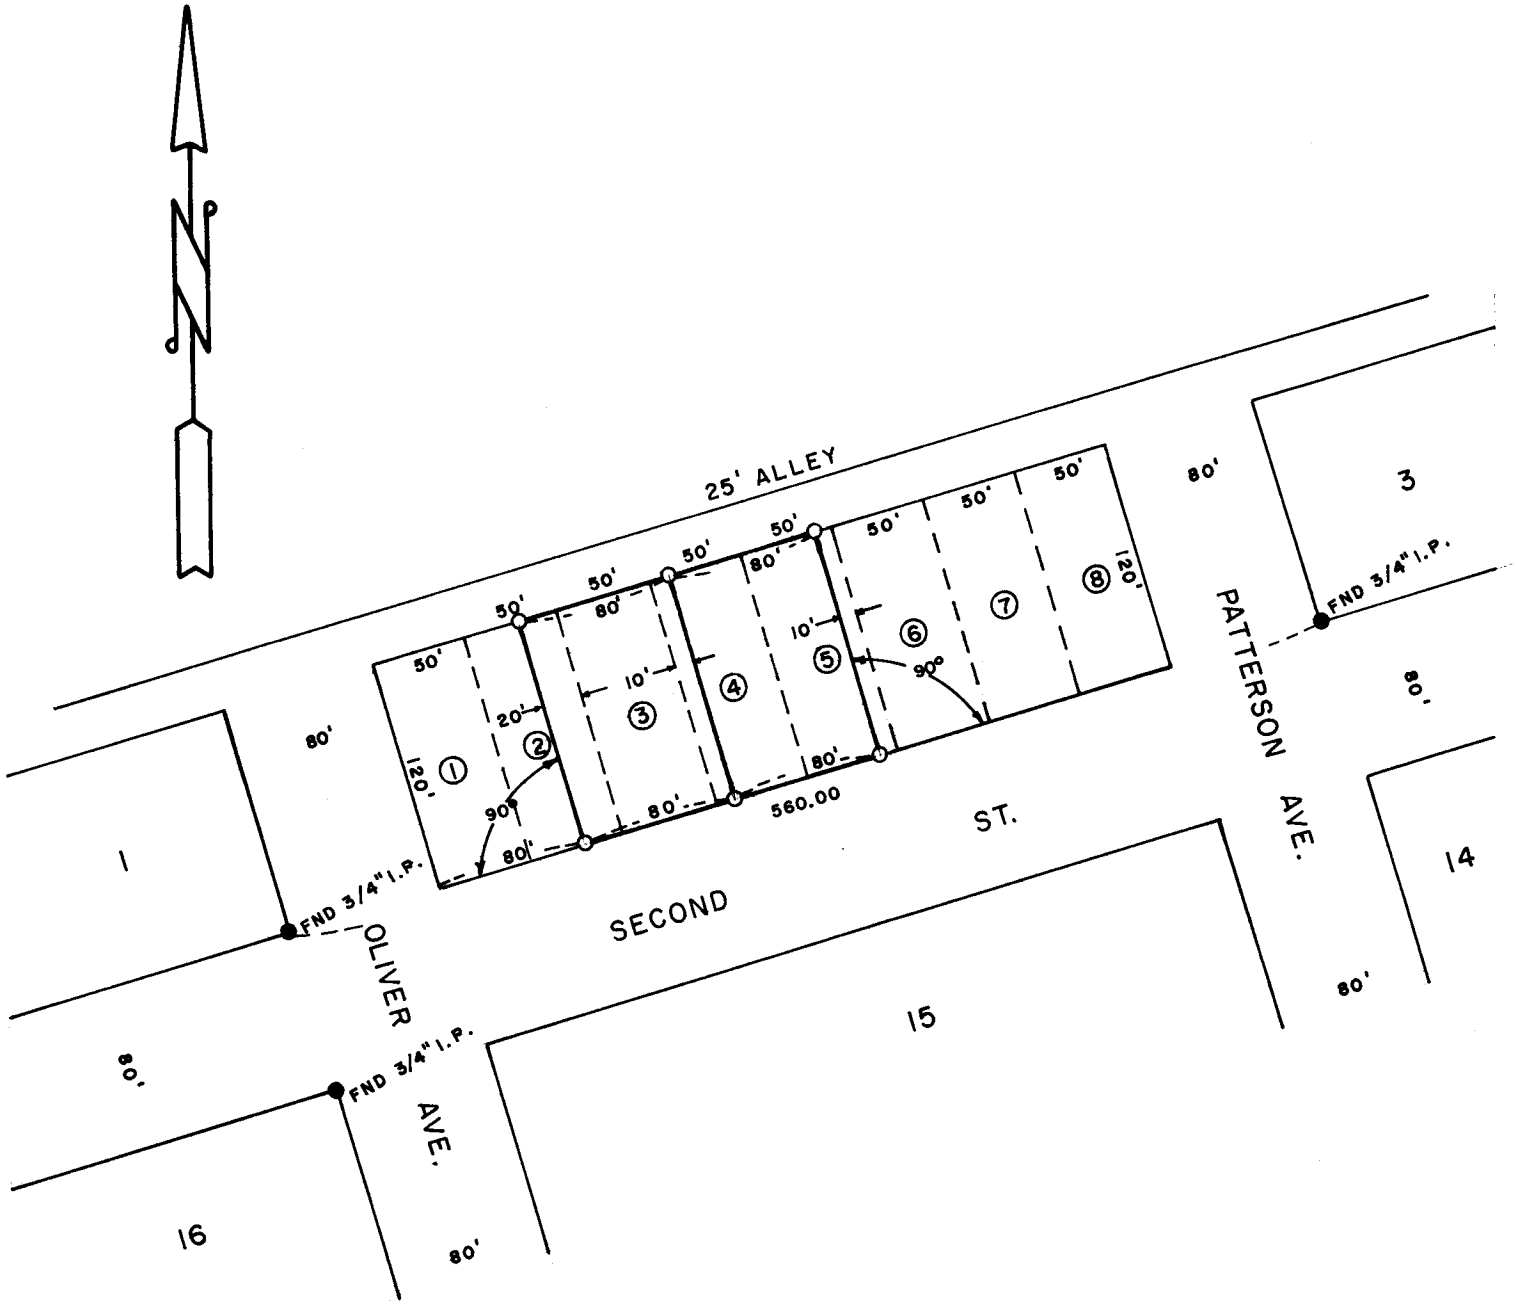

SURVEY FOR UNDERWOOD - LECHELT

LOCATION BLK 2, MCNARY ADDITION, S.E.1/4,

SEC. 8 , T 5 N, R 28 E, W.M., UMATILLA COUNTY, OREGON

DATE 6 - 1 - 78 SCALE: 1" = 100'

MONUMENTS FOUND (000) OF RECORD

IRON RODS SET 1/2" JOB NO. S7805203

EDWARDS SURVEYING P. O. Box 763

567-3336 Hermiston, Ore.

P-037-AX

REGISTERED PROFESSIONAL LAND SURVEYOR

G. Dennis Edwards

OREGON
JULY 16, 1971
G. DENNIS EDWARDS
951