


BRUNING 40-22 37139

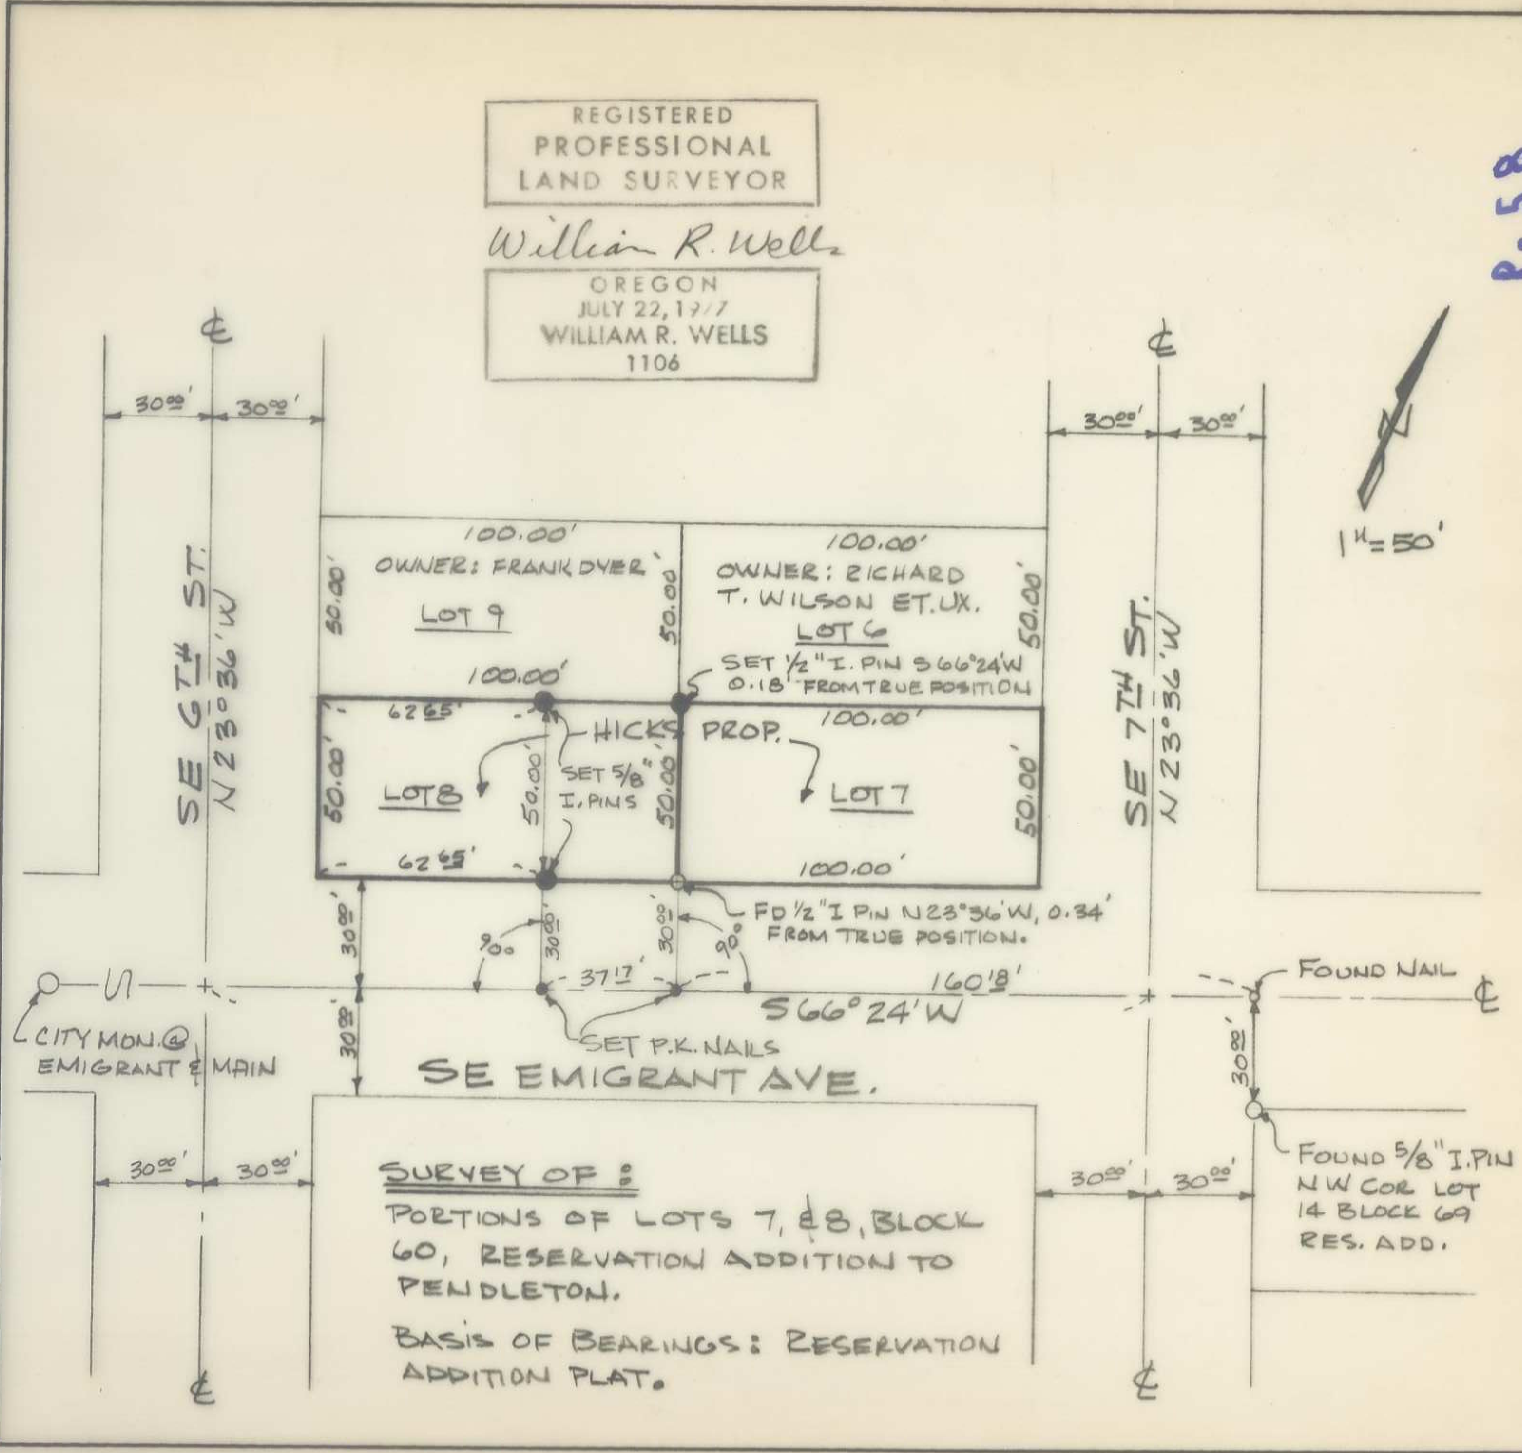

REGISTERED
PROFESSIONAL
LAND SURVEYOR

William R. Wells

OREGON
JULY 22, 1977
WILLIAM R. WELLS
1106



P-58

WALLULIS PROJECT NO:	78-102
AGENCY PROJECT NO:	—
PROJECT:	SURVEY FOR: NICK HICKS
WALLULIS & ASSOCIATES, INC. ENGINEERING & PLANNING 5 S. E. NVE AVENUE 100 EAST MAIN PENDLETON, OREGON 97051 HERMISTON, OREGON 97038 503 336-1199 FAX 503 337-1007	
SCALE: 1" = 50'	TITLE: SURVEY
DATE: 5/30/78	DES BY:
DR BY:	DR BY:
CK BY: WRW	CK BY: WRW
REVISIONS	
DRAWING:	
SHEET 1	OF 1

P-58-A1