


PLAT OF SURVEY OF SEC. 25  
 T 1 N., R. 31 E., W. M.,  
 For C. J. Jennings & Robert Hoeft.  
 Jan. 21-23 1915

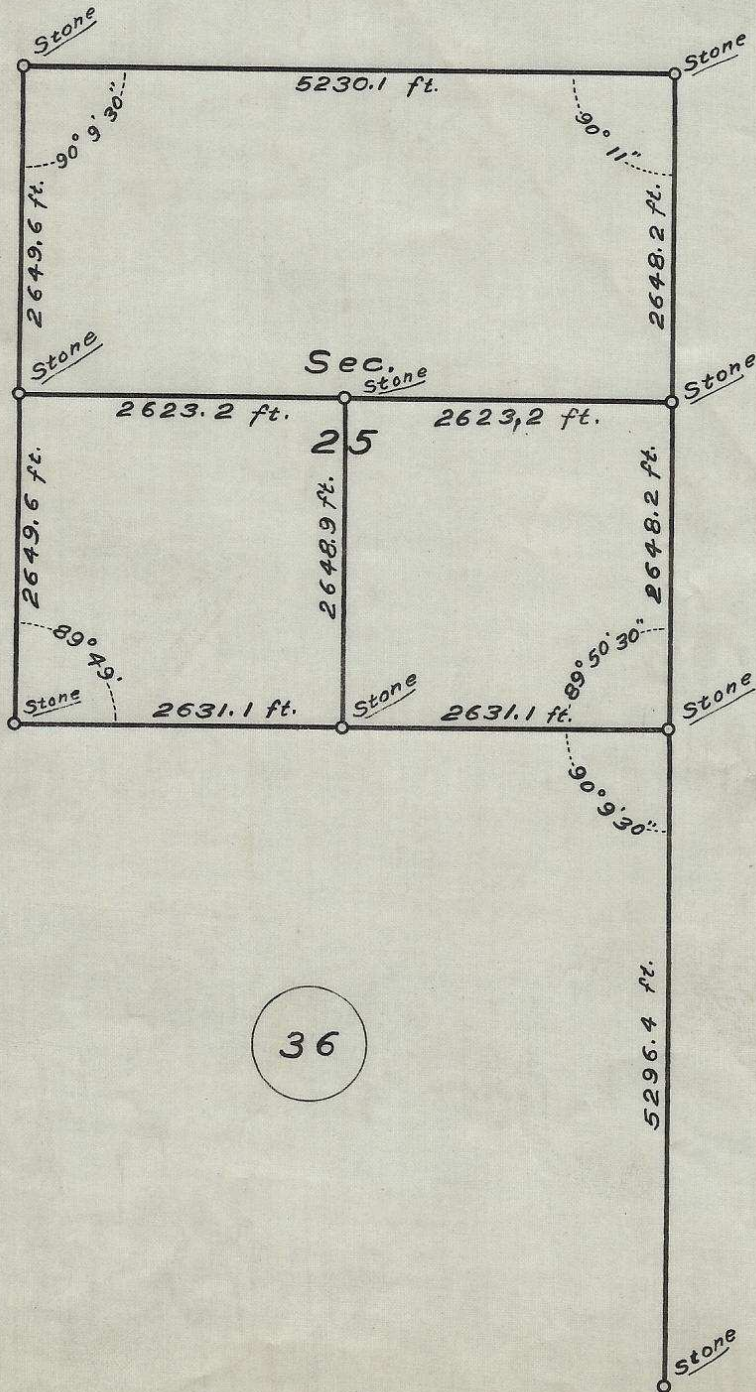

36

Geary Kimbrell Surveyor

G-52-AX A-48-130-T