


Q-145-AX

NE Cor. lot 2 Blk. 2
Currys Add.

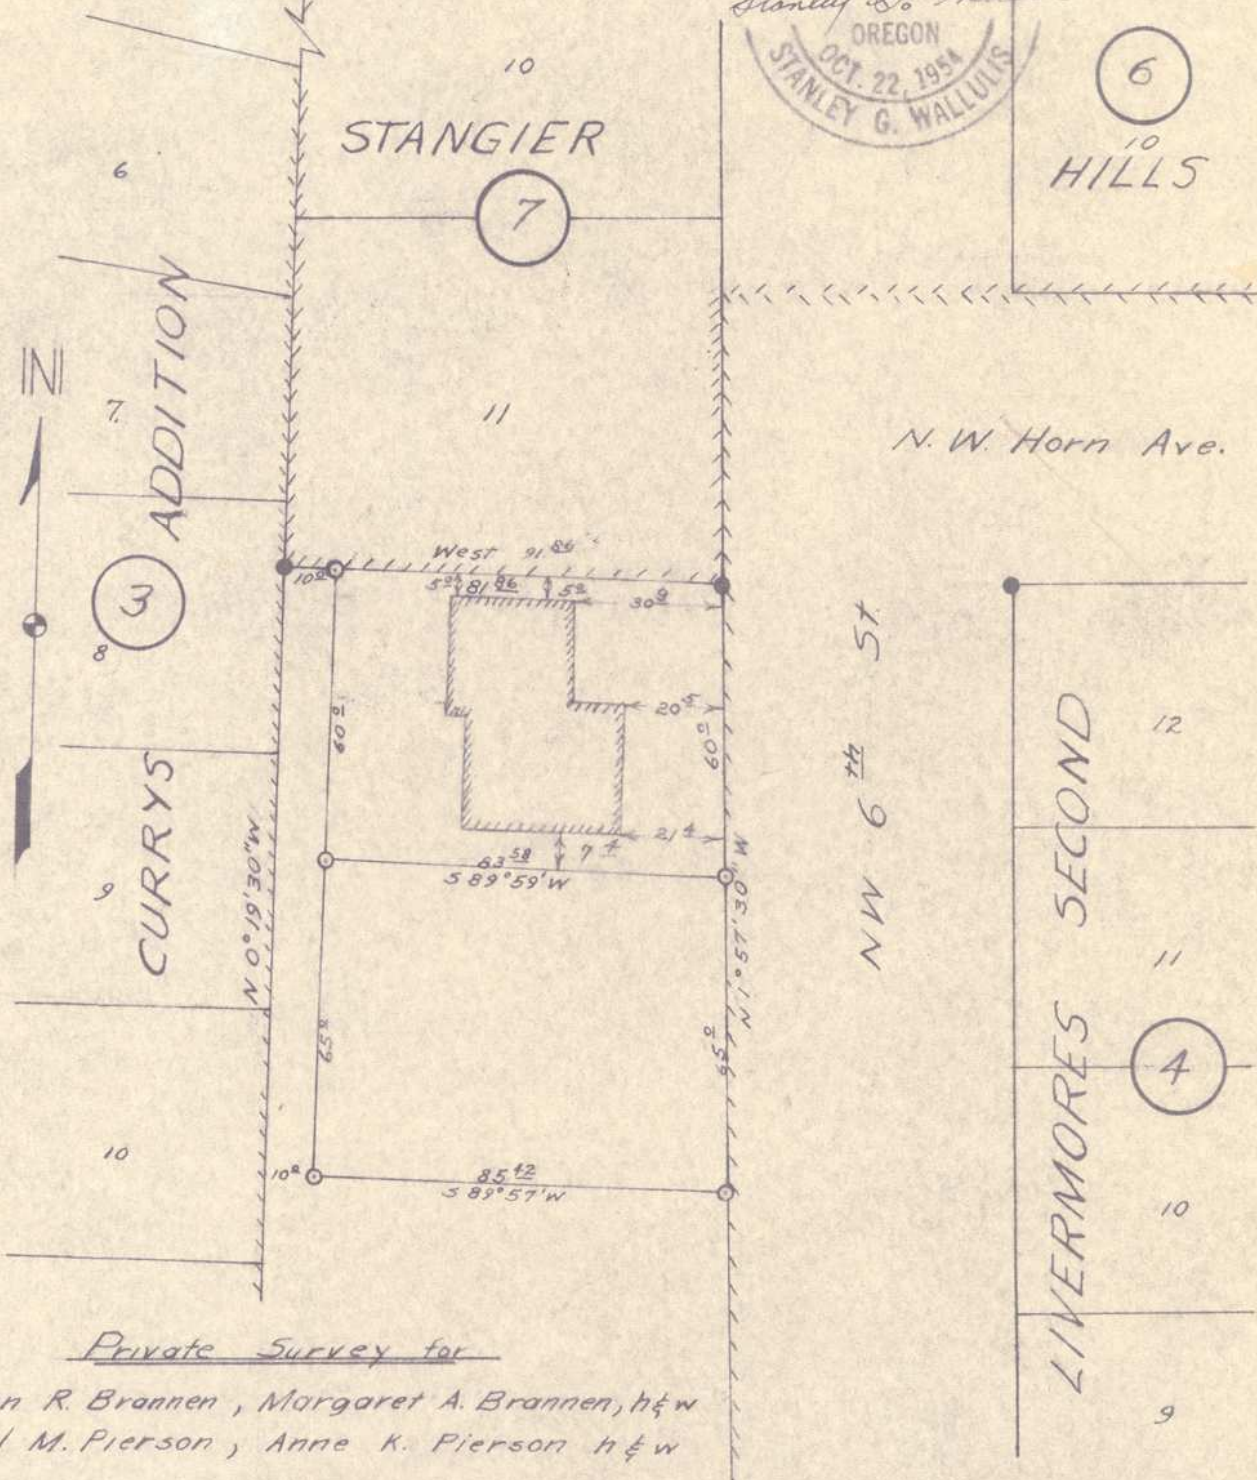

Private Survey for

John R. Brannen, Margaret A. Brannen, h & w
Earl M. Pierson, Anne K. Pierson h & w

Legend

- Points Found ●
- Points Set ○

NW ⁴ SE ⁴ 3	
SCALE 1" = 40'	DATE: Mar 12, 1955
WALL AND TENNESON Engineers Pendleton Oregon	

Robin Subid

Q-145-AX