


②-170-Ax

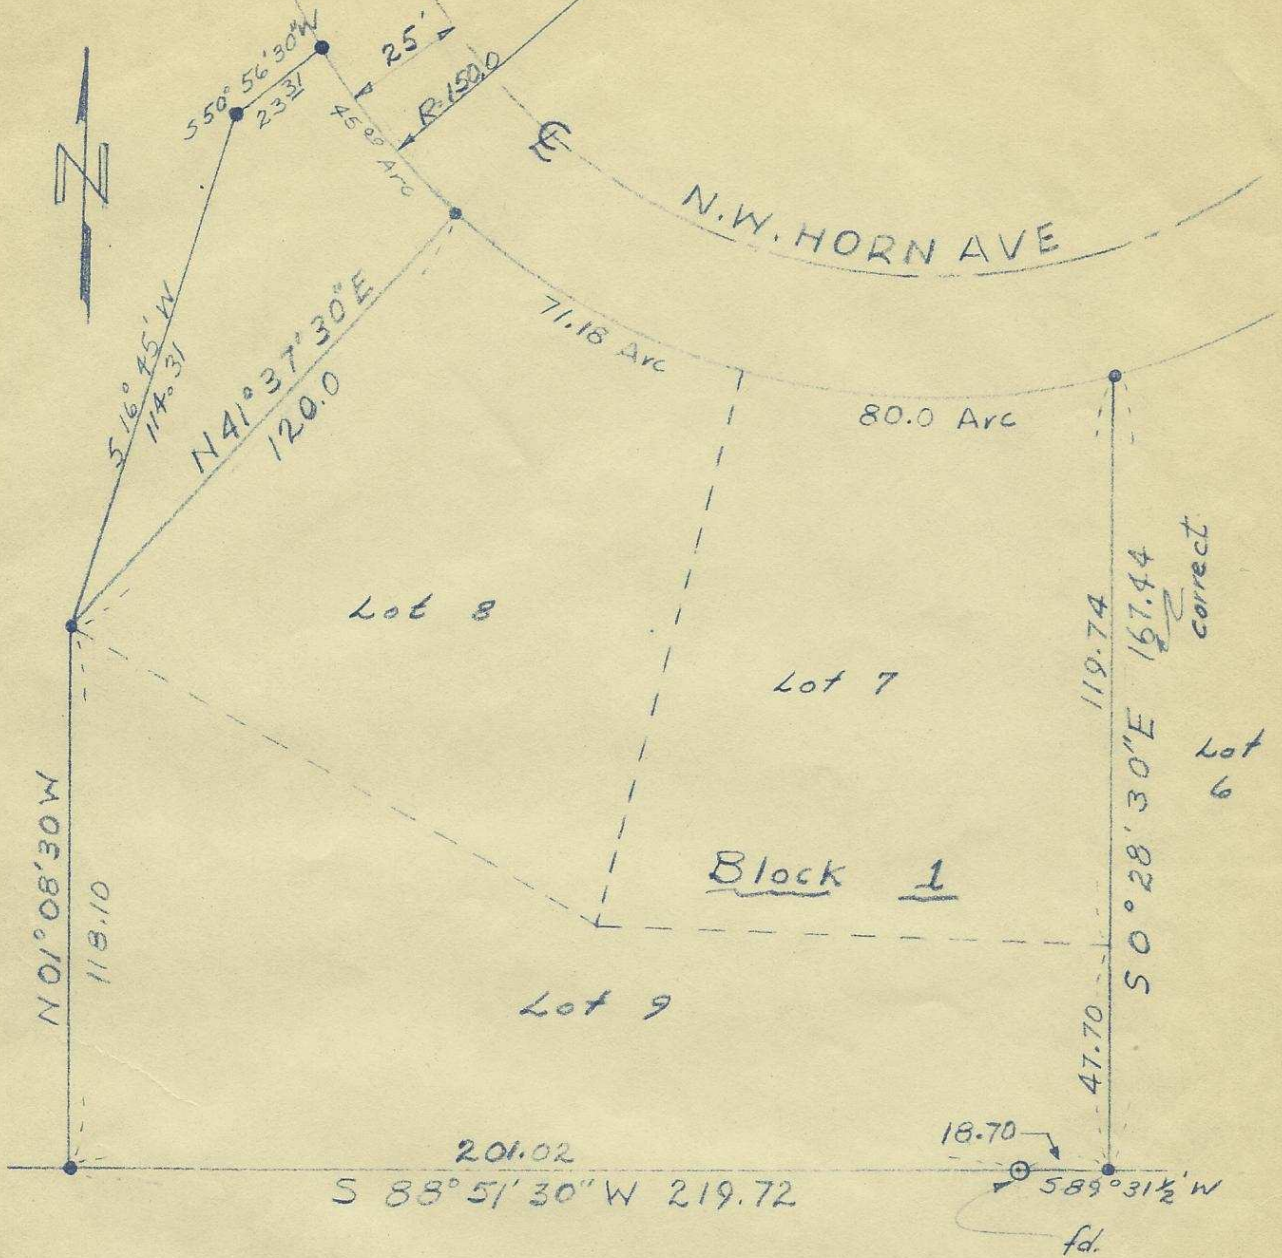

LOT 7, 8, 9, BLOCK 1 WEST HILLS ADD'N. TO THE CITY OF PENDLETON, OREGON.



Pins Set ---•

NW 1/4 SW 4 (3)
NE 1/4 " (3)

CA

SCALE: 1" = 40 ft

DATE: 2-13-57

WALL AND TENNESON

Engineers

Pendleton Oregon

234

②-170-Ax