


NE Cor. lot 2, Blk. 2  
Currys Add.

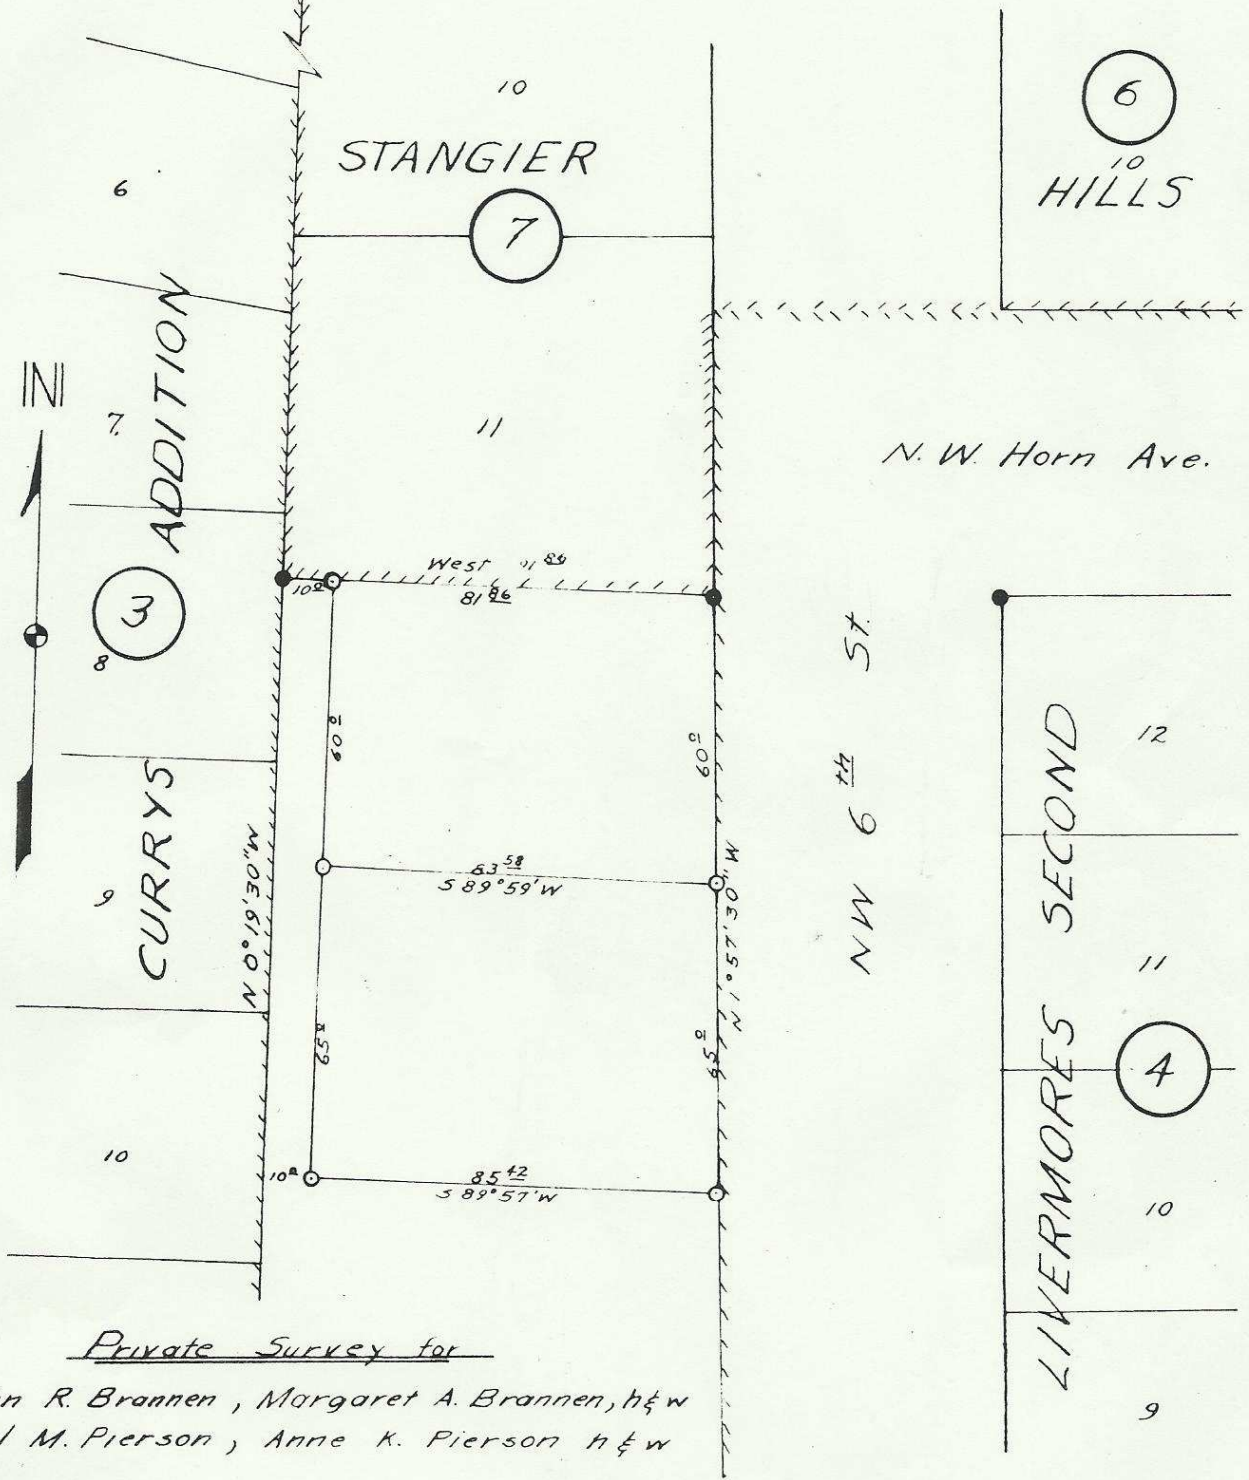

Private Survey for  
John R. Brannen, Margaret A. Brannen, h & w  
Earl M. Pierson, Anne K. Pierson h & w

Legend  
Points Found ●  
Points Set ○

3DA  
Q-175-Ax  
SCALE 1" = 40'  
DATE Mar 12, 1955  
WALL AND TENNESON  
Engineers  
Pendleton Oregon

2N32 03 NR