


9-178-Ax

3/4 inch dia. iron pipe 18" long

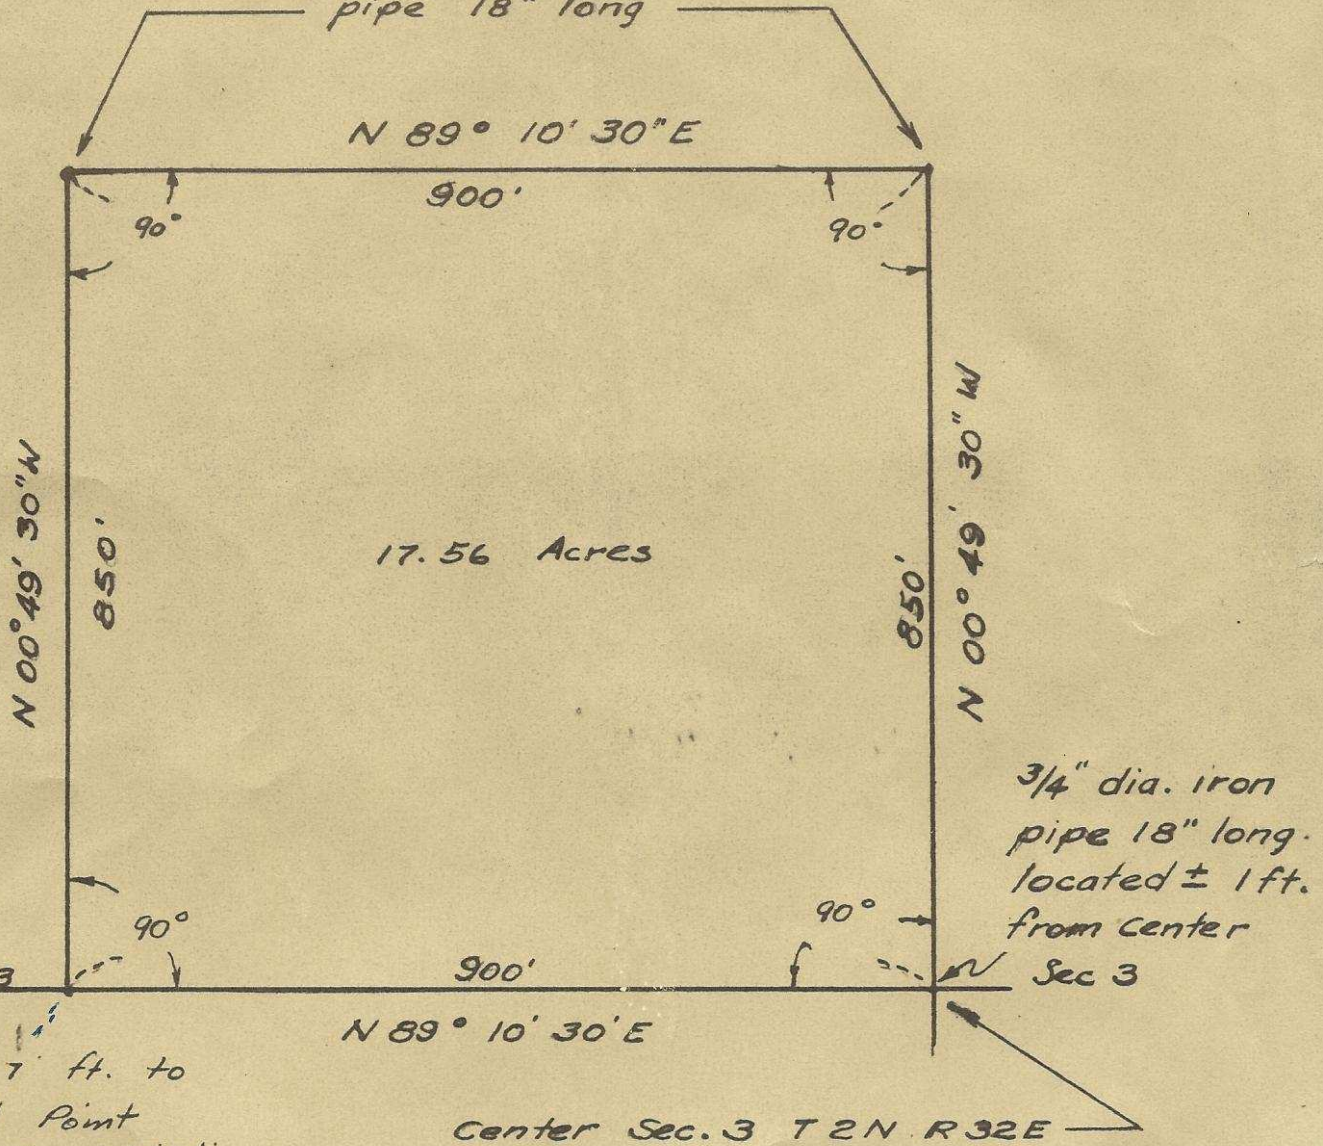

SE 1/4 NW 43



|   |                   |
|---|-------------------|
| Surveyed by Archie French<br>Reg Prof Engr. Oregon. |                   |
| For: James H. Raley<br>Pendleton, Oregon            |                   |
| Scale 1" = 200'                                     | Sheet No 1 of 10P |
| Date 10/7/53  | 885               |

9-178-Ax