

E S.W. 1/4 STREET

30°

100°

50°

50°

LOT 14
BLOCK 276
RESERVATION ADDITION
TO THE

Set iron pin

Set iron pin

CITY OF PENDLETON, ORE.


50°

50°

LOT 13

100°

30°

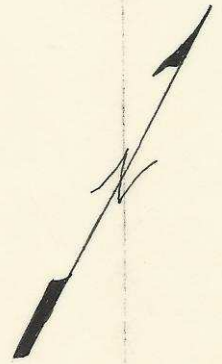

SURVEY FOR
BROADWAY FINANCE

Scale 1" = 25'

Date: 9-27-62

STANLEY G. WALLULIS
CONSULTING Engineer
P.O. Box 91

PENDLETON

OREGON

Q-236-Ax

10DC