


07.9

Q-303-AX

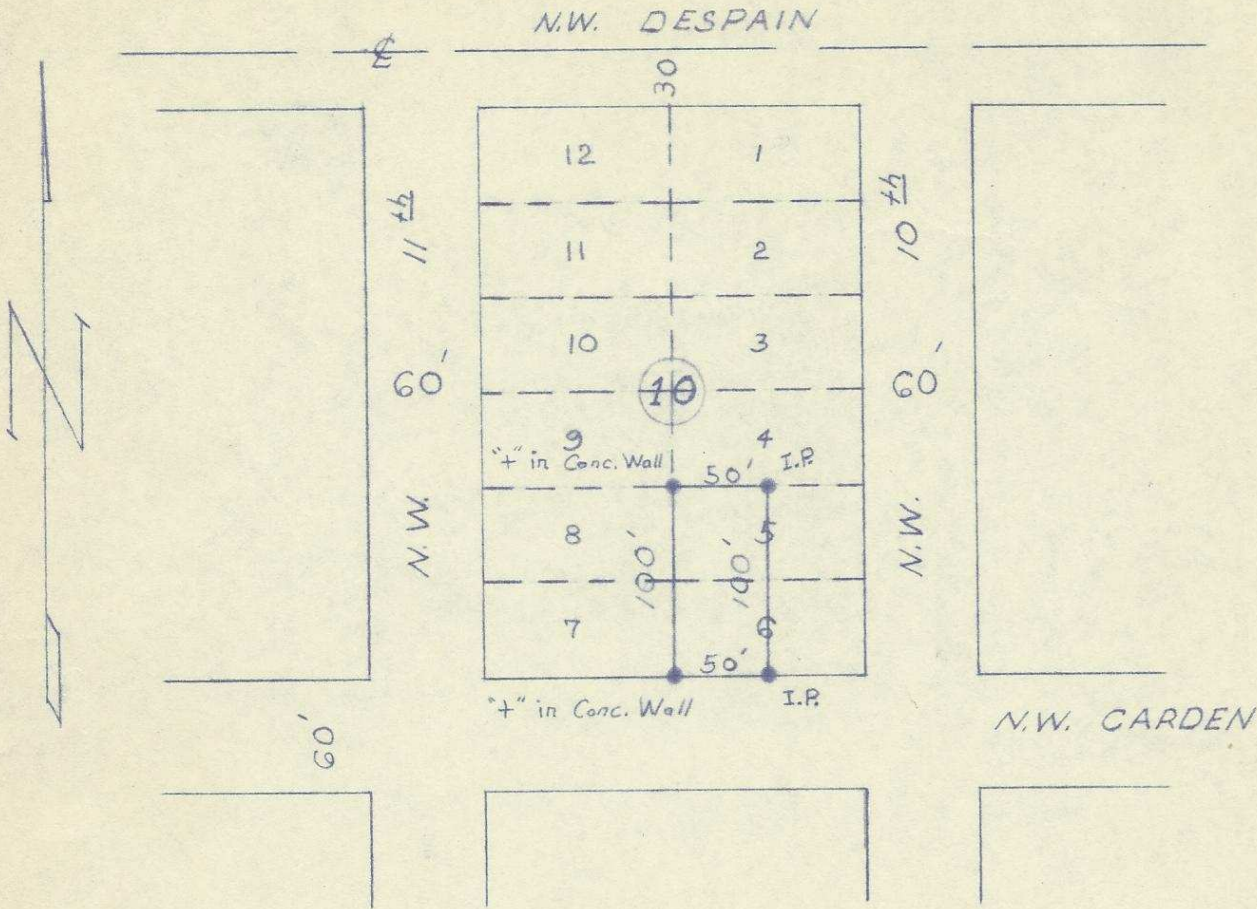

NE NW 10

REGISTERED
OREGON
 LAND SURVEYOR

Wayne O. Harris

MAY 6, 1955
 WAYNE O. HARRIS
 346

HAYES AND HARRIS			
WEST HALF OF LOTS 6 AND 5			
HOUSER'S ADDITION			
PENDLETON, OREGON			
<i>Q-303-AX</i>			
SCALE	DATE	DRN. BY	DRNG. NO.
1" TO 100'	3-28-63	WOH	63-177