

Q-315-Ax


orig

S.W. 6th St.

S.W. 5th St.

Arnold & Raleys Addition.

Boundary of Reservation Add.

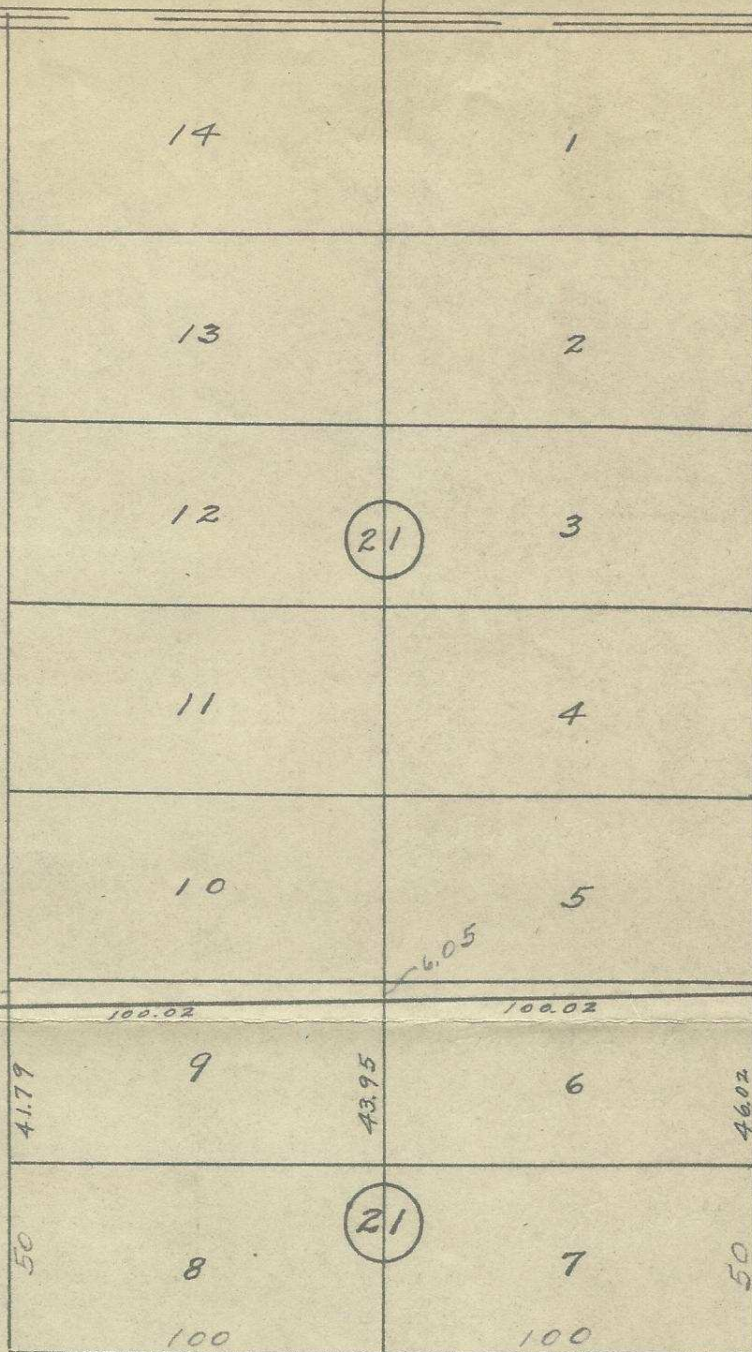

S.W. Dorion Ave.

AC 1AD

SW 4 NW 4 10



Plat of Block 21 of
 Reservation Addition and
 Block 21 of Arnold & Raleys Add'n
 to the town, New City of Pendleton
 Oregon.

Scale: 1 inch = 50 Feet.

Surveyed, Staked & Platted - April - 1948 -
 By W. E. O. Criger.

Q-315-Ax

465

X