


Q-338-AX

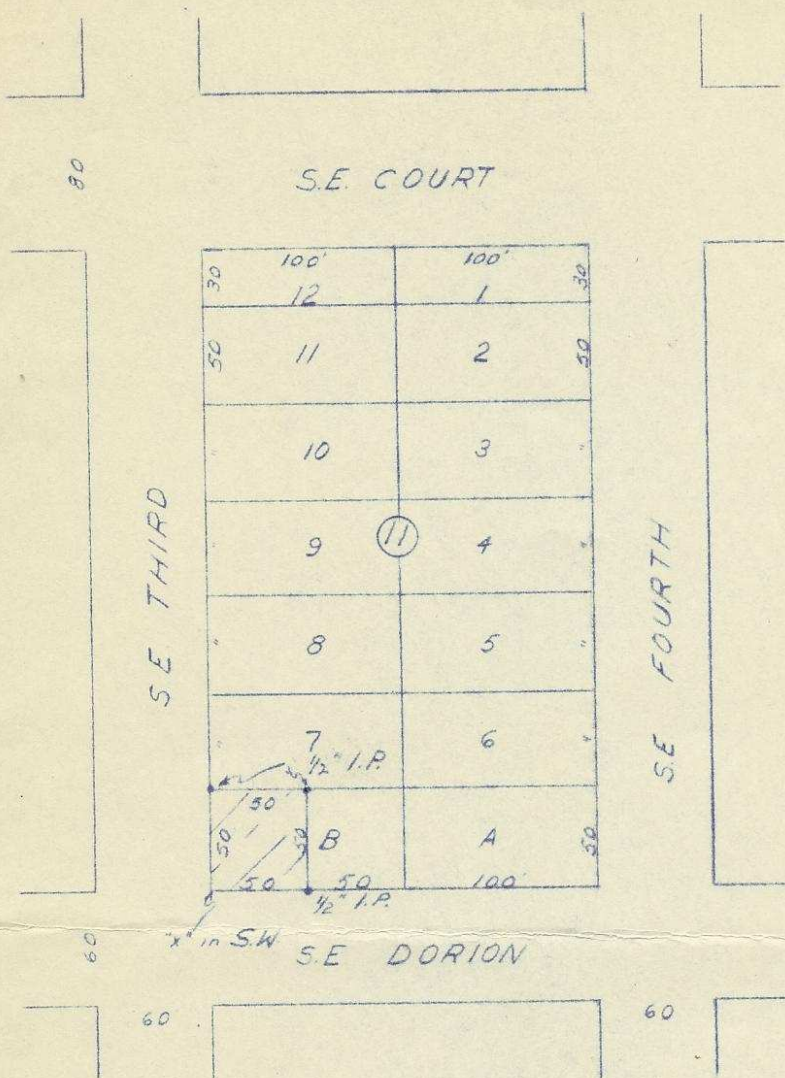

REGISTERED
OREGON
 LAND SURVEYOR

Wayne O. Harris

MAY 8, 1955
WAYNE O. HARRIS
346

NW ⁴ NW ⁴ 11			
HAYES AND HARRIS			
Survey For			
ROBERT W. COLLINS			
Q-338-AX			
W. 1/2 Lot B, Original Town Pendleton, Oregon			
Scale	Date	Dwn. By	Dwg. No.
1"=100'	6/20/57	W.O.H.	47

168