


OR 19
Q-350-Ax

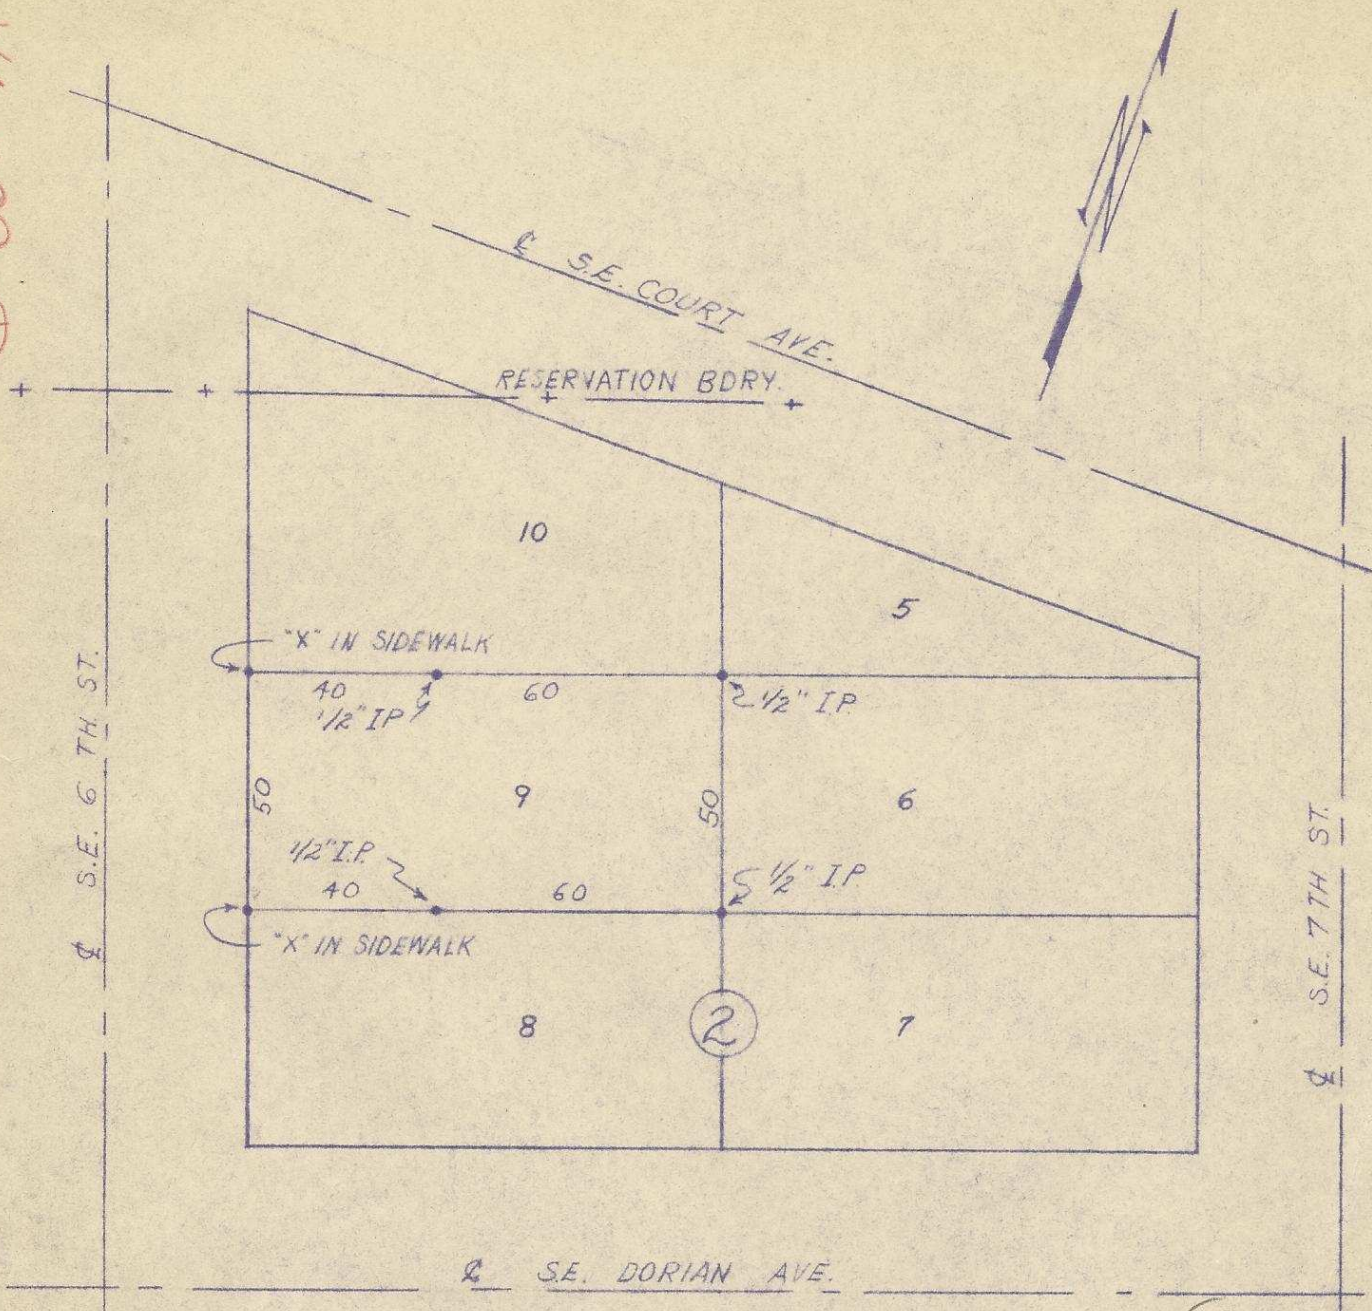

NE 1/4 NW 1/4 10

REGISTERED
OREGON
LAND SURVEYOR

Wayne O. Harris
MAY 6, 1955
WAYNE O. HARRIS
346

HAYES AND HARRIS

SURVEY FOR
FERGUSON COMRIE
LOT 9 BLOCK 2
RESERVATION ADDITION TO
PENDLETON, OREGON

SCALE	DATE	DRW BY	DRW NO.
1"=40'	5/11/59	RWC	59-91

Q-350-Ax