


Twp 2 N, R 32 E N.M.  
Twp 2 N, R 33 E N.M.

1089

76.50 Ch.

UMATILLA RIVER

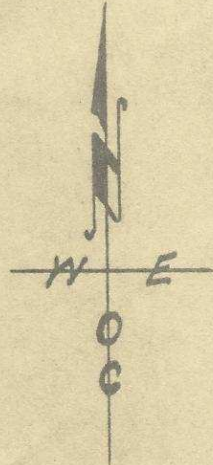

Lot-1

12

Lot-2

2° C.L.  
Δ 40° 09'  
T = 10472

EQUATION

234


S. E/4 of N.W/4

Old Oregon Trail  
N. 67° 59' E.

West Line Umatilla Reservation.  
2574 283  
2574 4138  
3.0° 04' W.

U.S. Brass Cap Marker

S.W/4

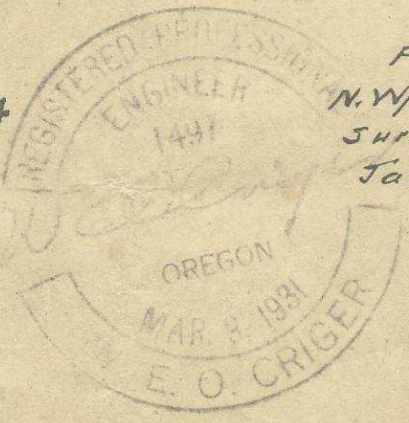

Plat showing  
N.W/4 of Sec. 7, T. 2 N., R. 33 E. N.M.  
Surveyed, Staked and platted,  
Jan. 1950 - By W.E.O. Criger.  
Scale 1" = 400'

OR 19  
Q-166-AX

951

So. Line Sec = 76.75 Ch.