
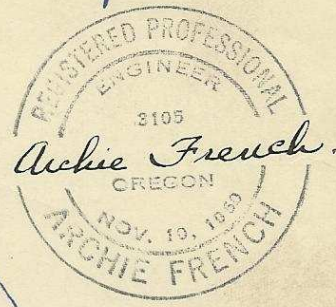


SURVEYED PLATTED & DRAWN  
 by Archie French  
 for HERMAN BEILKE  
 PENDLETON, OREGON  
 Scale 1" = 100' 12-18-53  
 Drg. No 17-B.

0019 0-495-A1

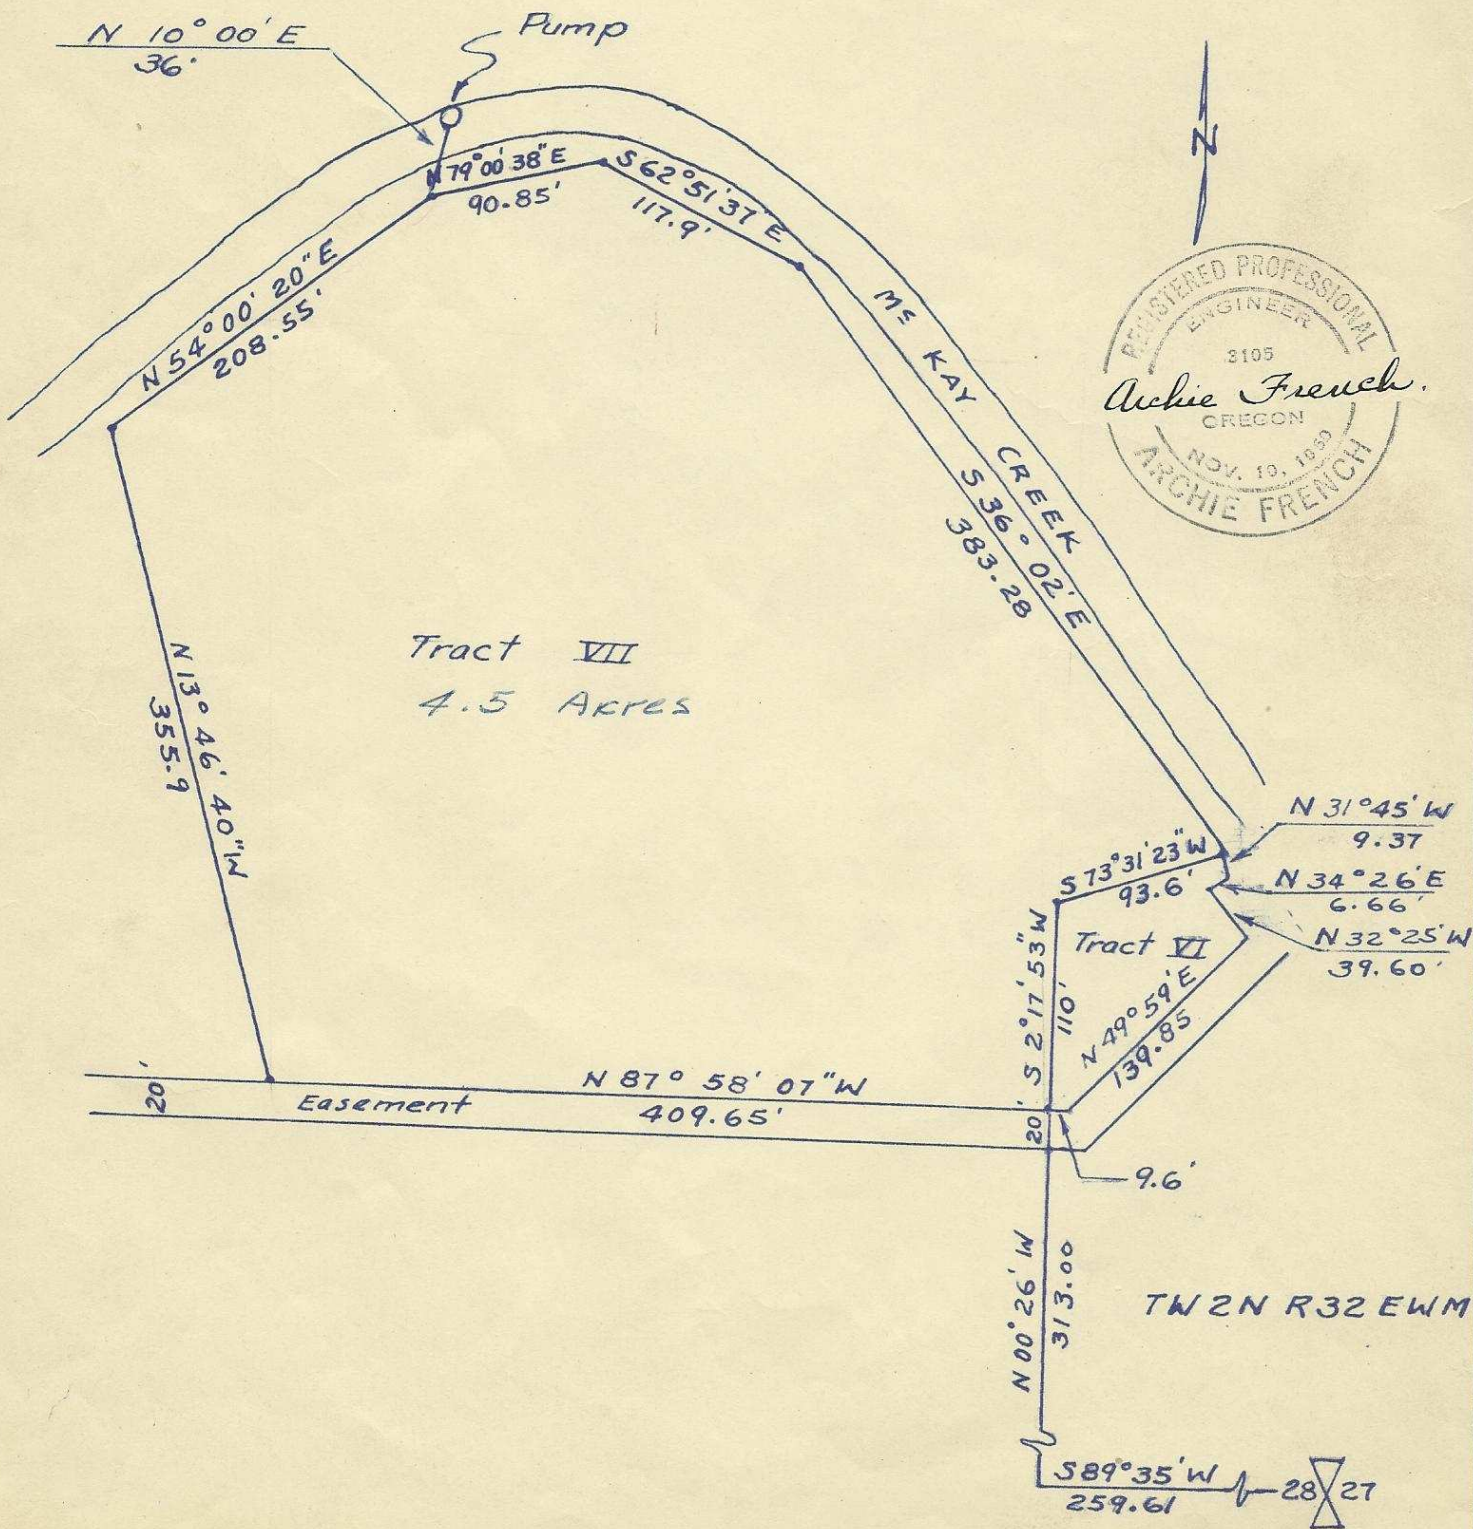

23