

SW QUARTER of the SW 1/4
 SECTION 2
 TOWNSHIP 4N
 RANGE 28E
 SCALE 1" = 500'
 250'


SHEET ___ of ___

Dec 1975



Donald L. Staebler

Q-562-AX

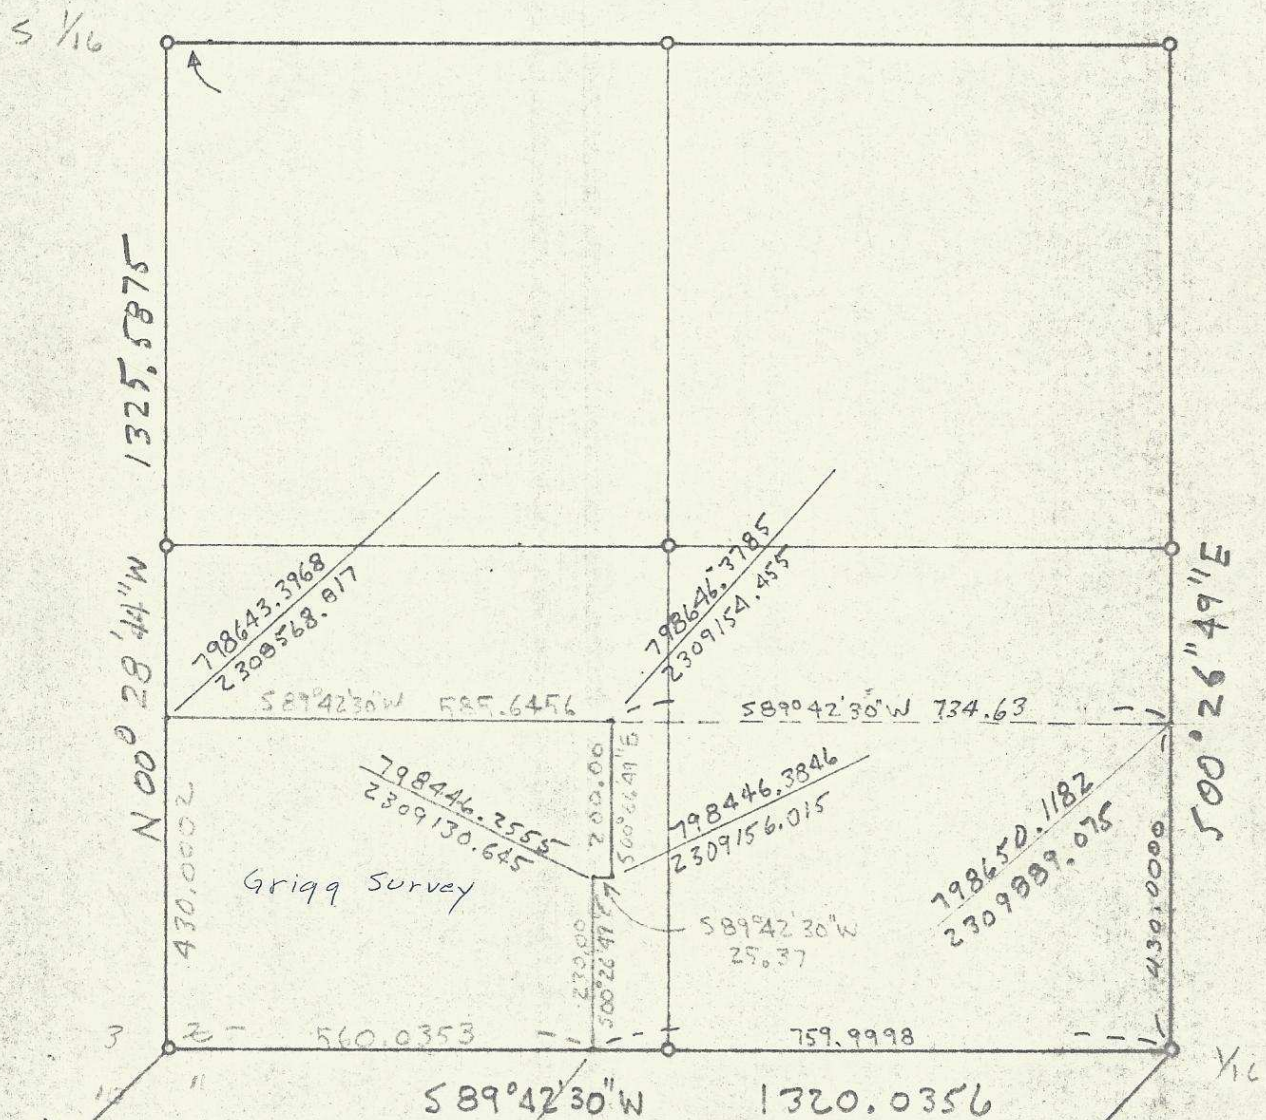

798213.4116
 2308572.411

798216.2225
 2309132.439


798220.1313
 2309892.429

NOTE:
 GRID BEARINGS
 TRUE DISTANCES
 BASE BEARING IS HERM. BUTTE - HERM. AIR
 S 56° 56' 39" E

Dec 1975

SW QUARTER
SECTION 2
TOWNSHIP 4N
RANGE 28E
SCALE 1" = 500'

SHEET ___ of ___

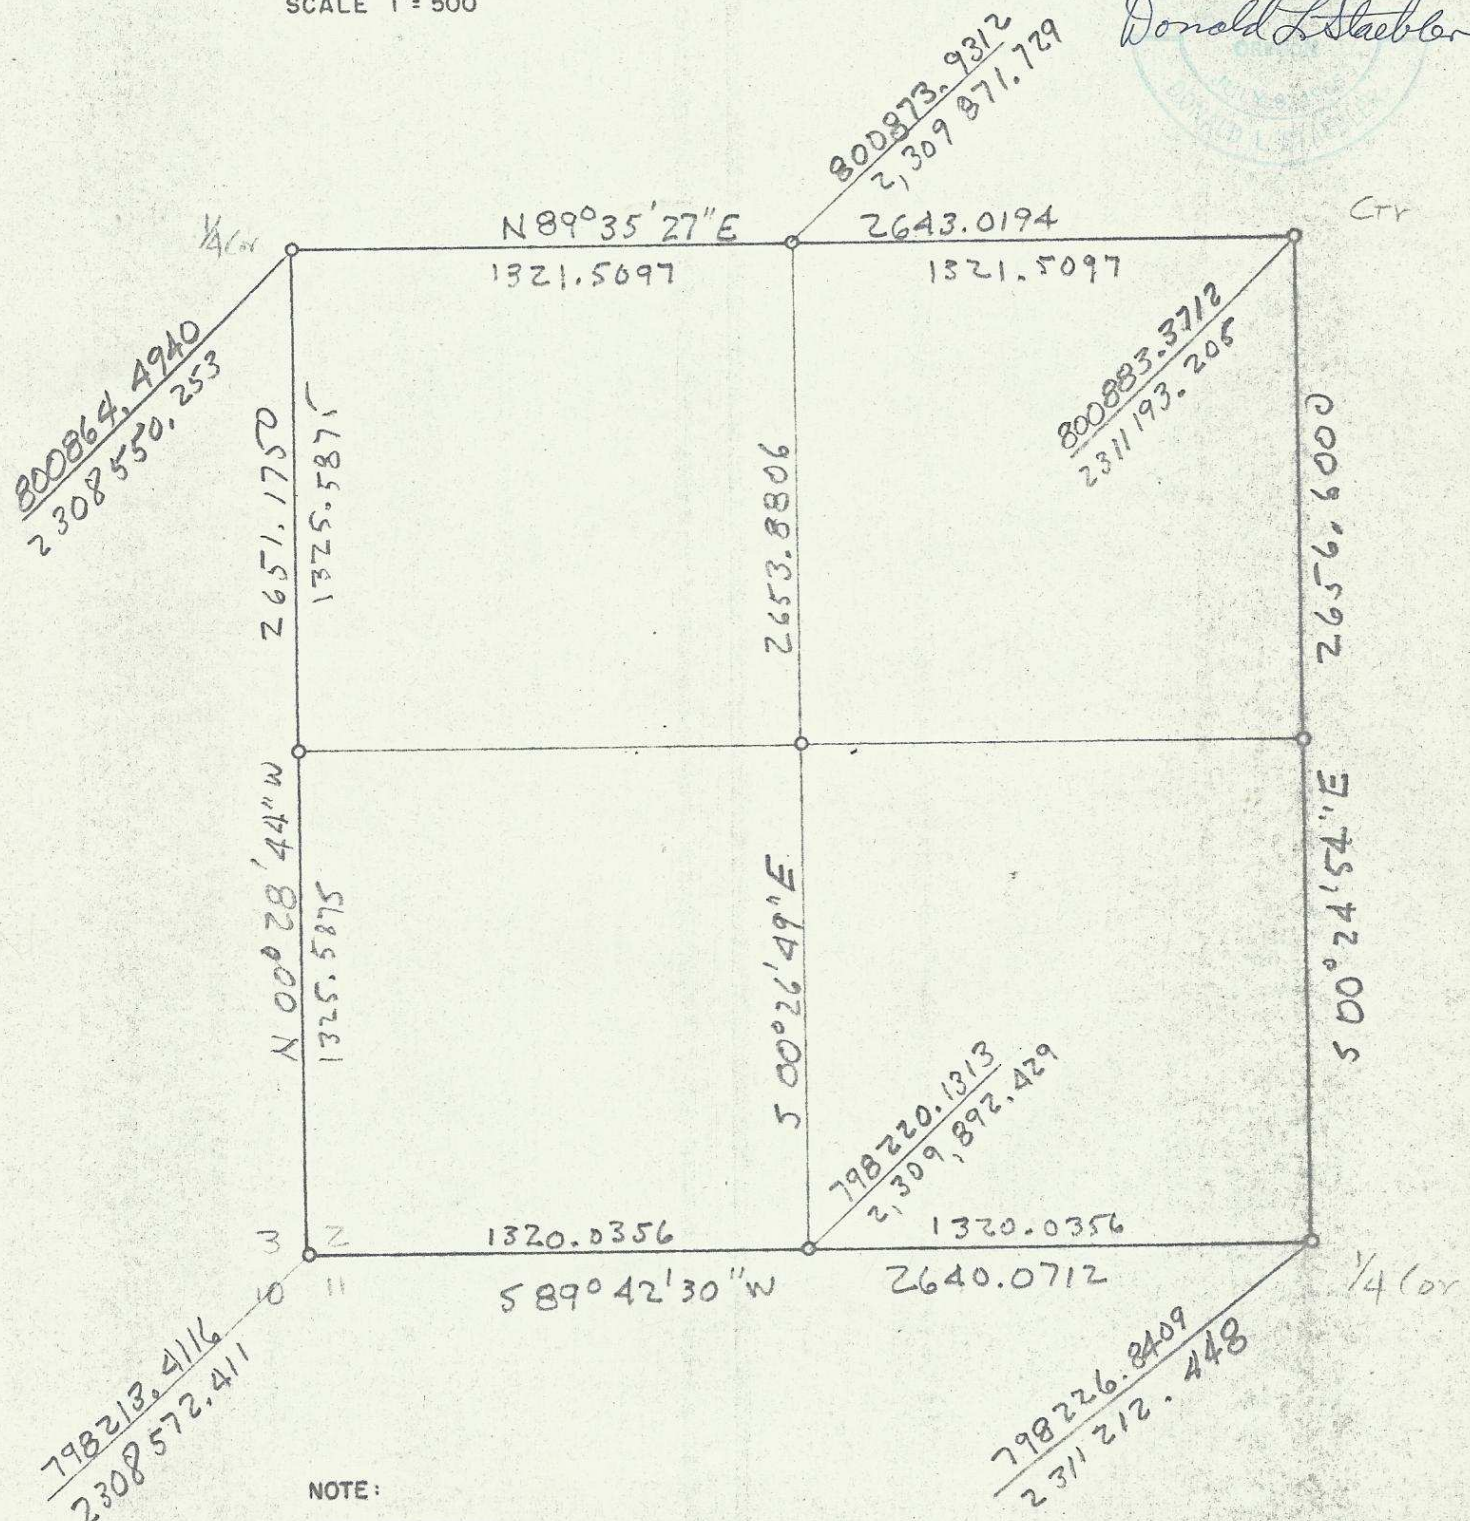

NOTE:

GRID BEARINGS
TRUE DISTANCES
BASE BEARING IS HERM. BUTTE - HERM. AIR
S $56^{\circ} 58' 39'' E$

