


Orig Q-575-HX

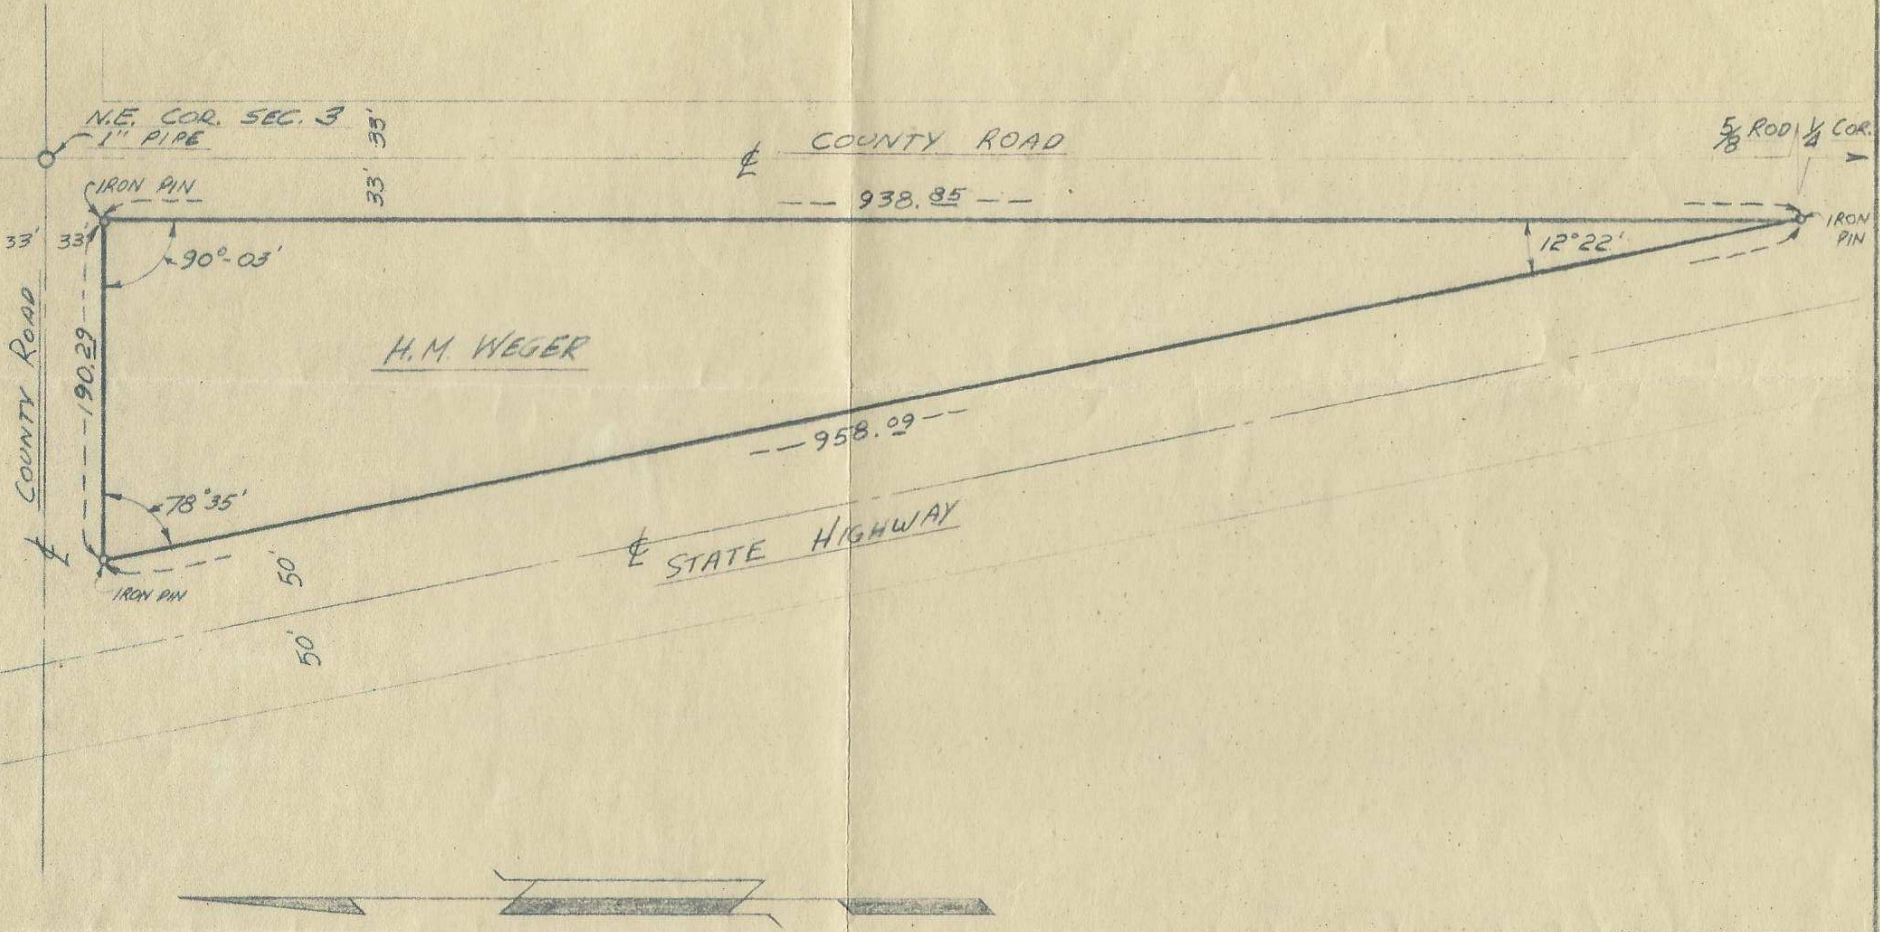

SCALE 1" = 100'

C. H. Storms & Associates

CONSULTING ENGINEERS — ARCHITECTS

304 DENNY BUILDING TELEPHONE 4170 WALLA WALLA, WASH.

- Mechanical
- Structural
- Hydraulic
- Sanitary
- Designs
- Land Surveys
- House Plans
- Blue Prints
- Estimates

A SURVEY FOR
H.M. WEGER
 IN NE 1/4 SEC. 3 T4 R2B EWN
 ORDINANCE, OREG.

Date 3-18-48
 Drawn By S.F.W.
 Checked By _____

510

SHEET 1 of 1