



R-52

Q-617-Ax
104

SKETCH SHOWING ENCROACHMENT OF ORIGINAL DESCRIPTION ON NW 3RD ST. ALSO SHOWING QUITCLAIM AREAS TO ESTABLISH PROPERTY LINE ON NORTH TO BE ALONG EXISTING WOVEN WIRE FENCE SCALE 1"=40 FEET

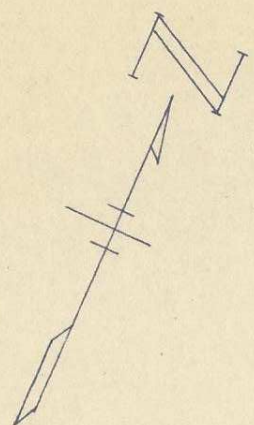

NE 10

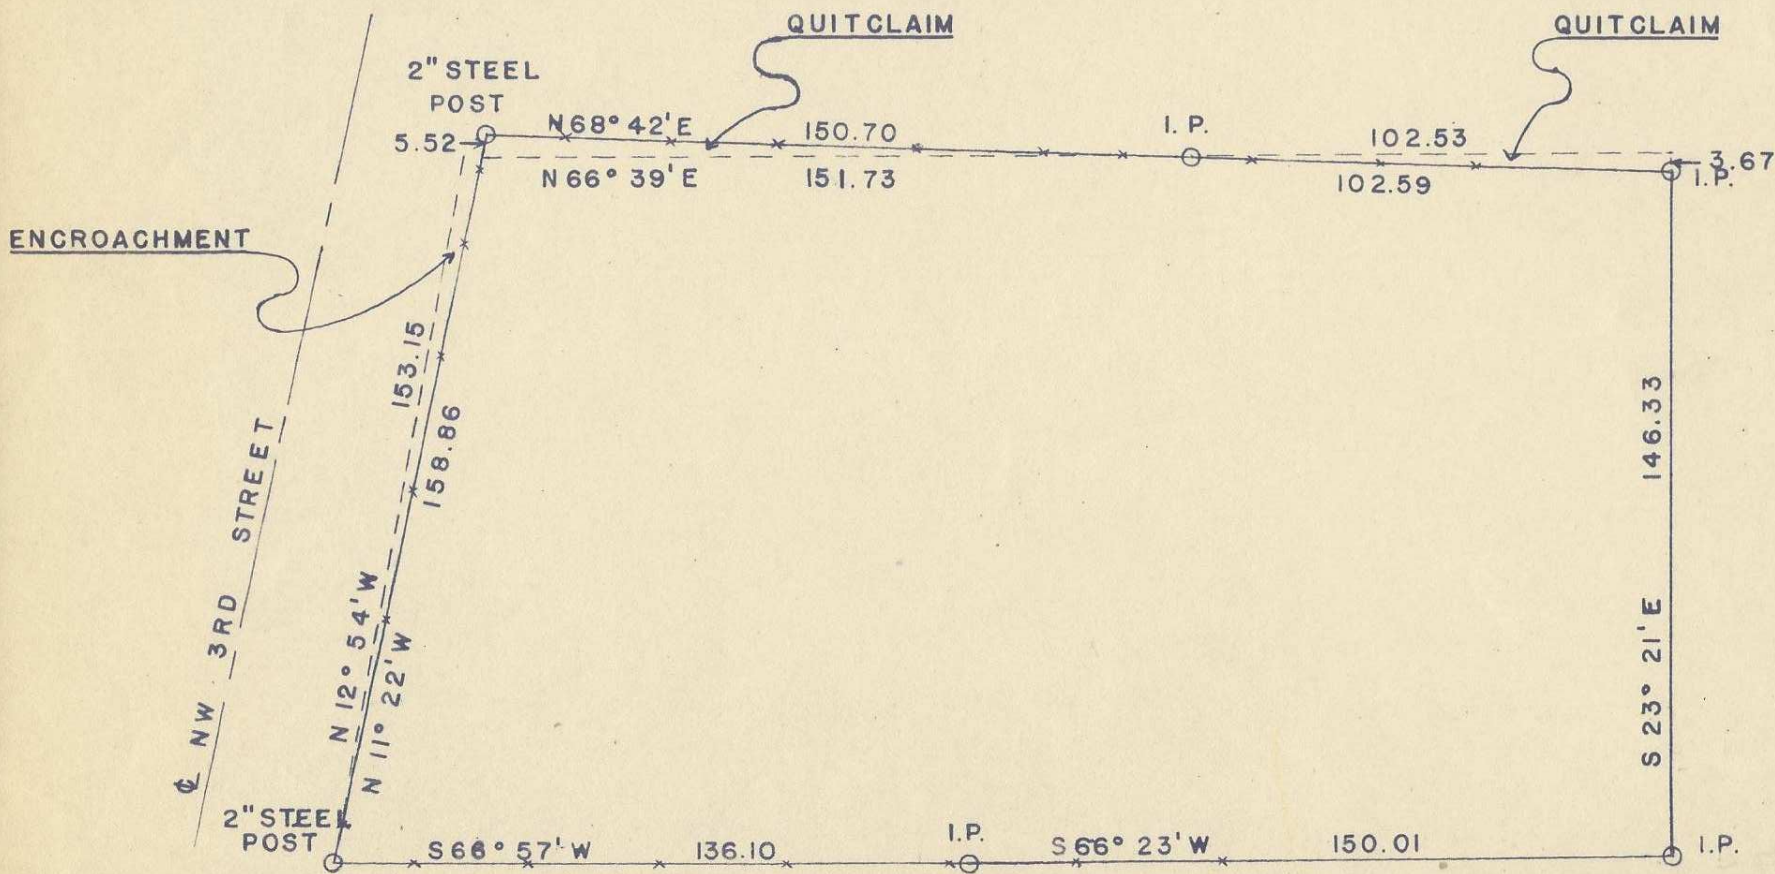

455A