Q-641-Ax

UMATILLA COUNTY, OREGON

Location: SW 1/4, NW 1/4 SEC. 11, T. 4 N., R. 28 E., W. M.

Scale 1" = 60'

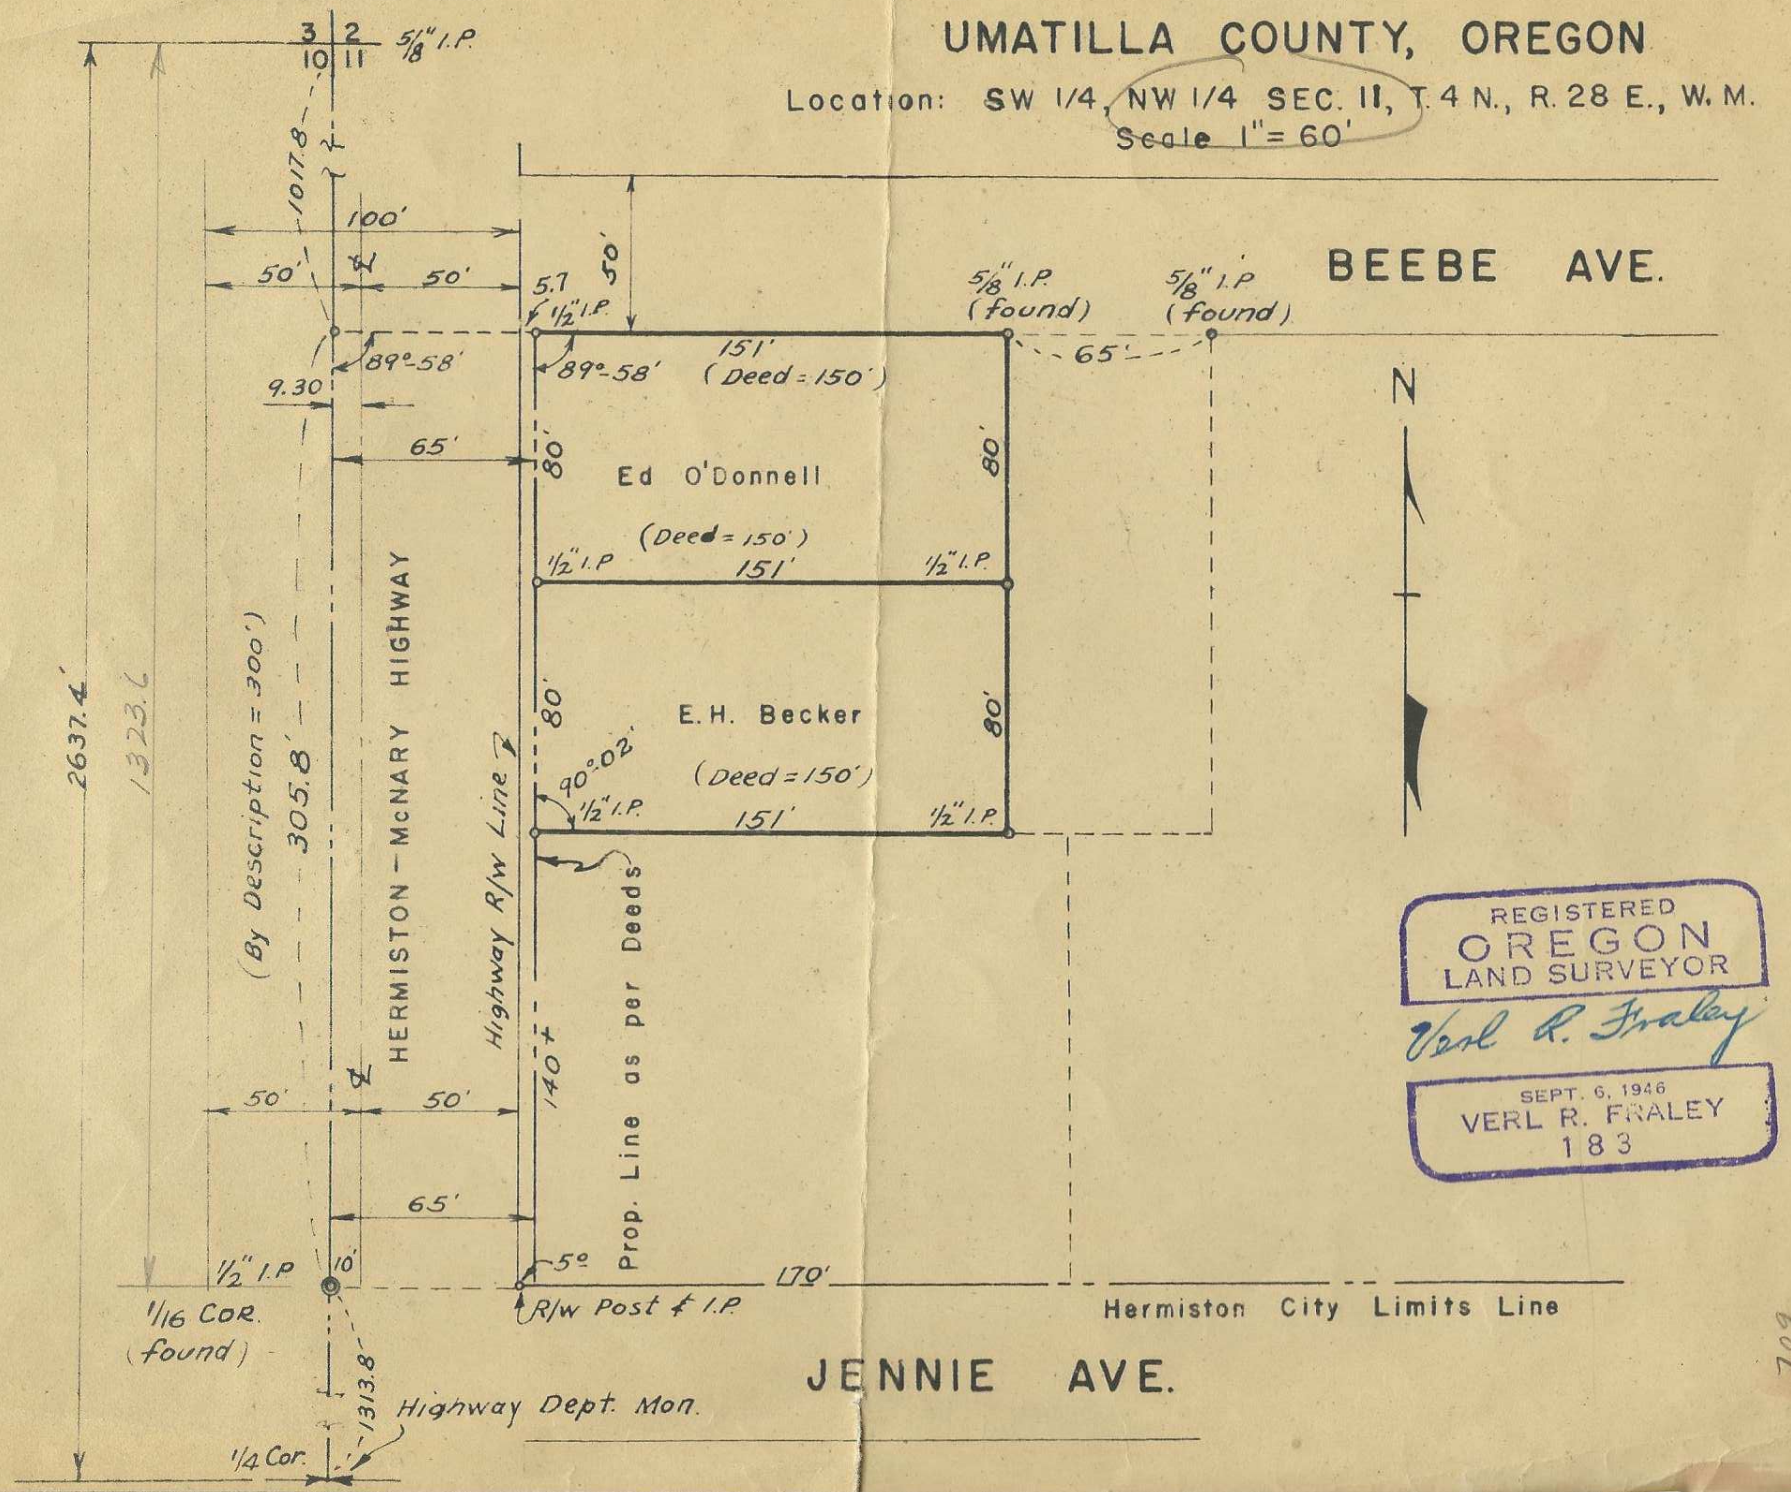

REGISTERED
OREGON
LAND SURVEYOR
Verl R. Fraley
SEPT. 6, 1946
VERL R. FRALEY
183

709