

REGISTERED  
**OREGON**  
 AND SURVEYOR  
*H. R. Fraley*  
 10-28-50  
 1916, 1945  
 HENRY W. FRALEY  
 183

**MAP OF  
 REEVES PROPERTY**



②-666-A1

IN THE N. 1/2 OF THE NE. 1/4 OF THE SE. 1/4 OF SECTION 16,  
 TOWNSHIP 4 N., RANGE 28E., W.M.

SCALE: 1" = 50'

N. 89°-06' W.  
 683'

3.03 Acres

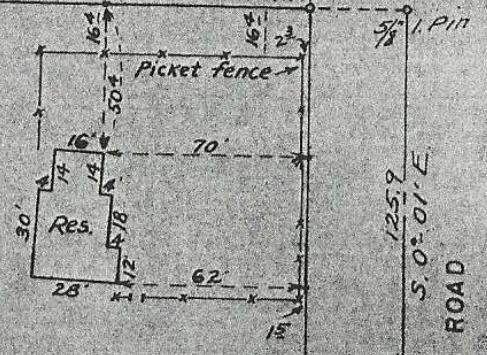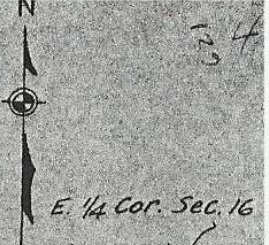

125.9  
 S. 0°-01' E  
 ROAD

STATE HIGHWAY NO. 207  
 ALSO BUTTERCREEK

