
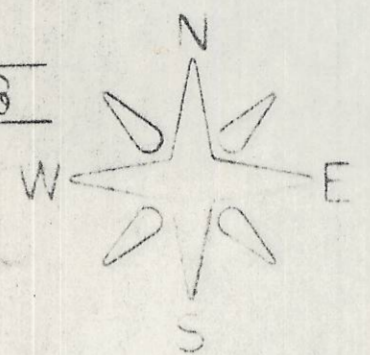


Q-677-Ax

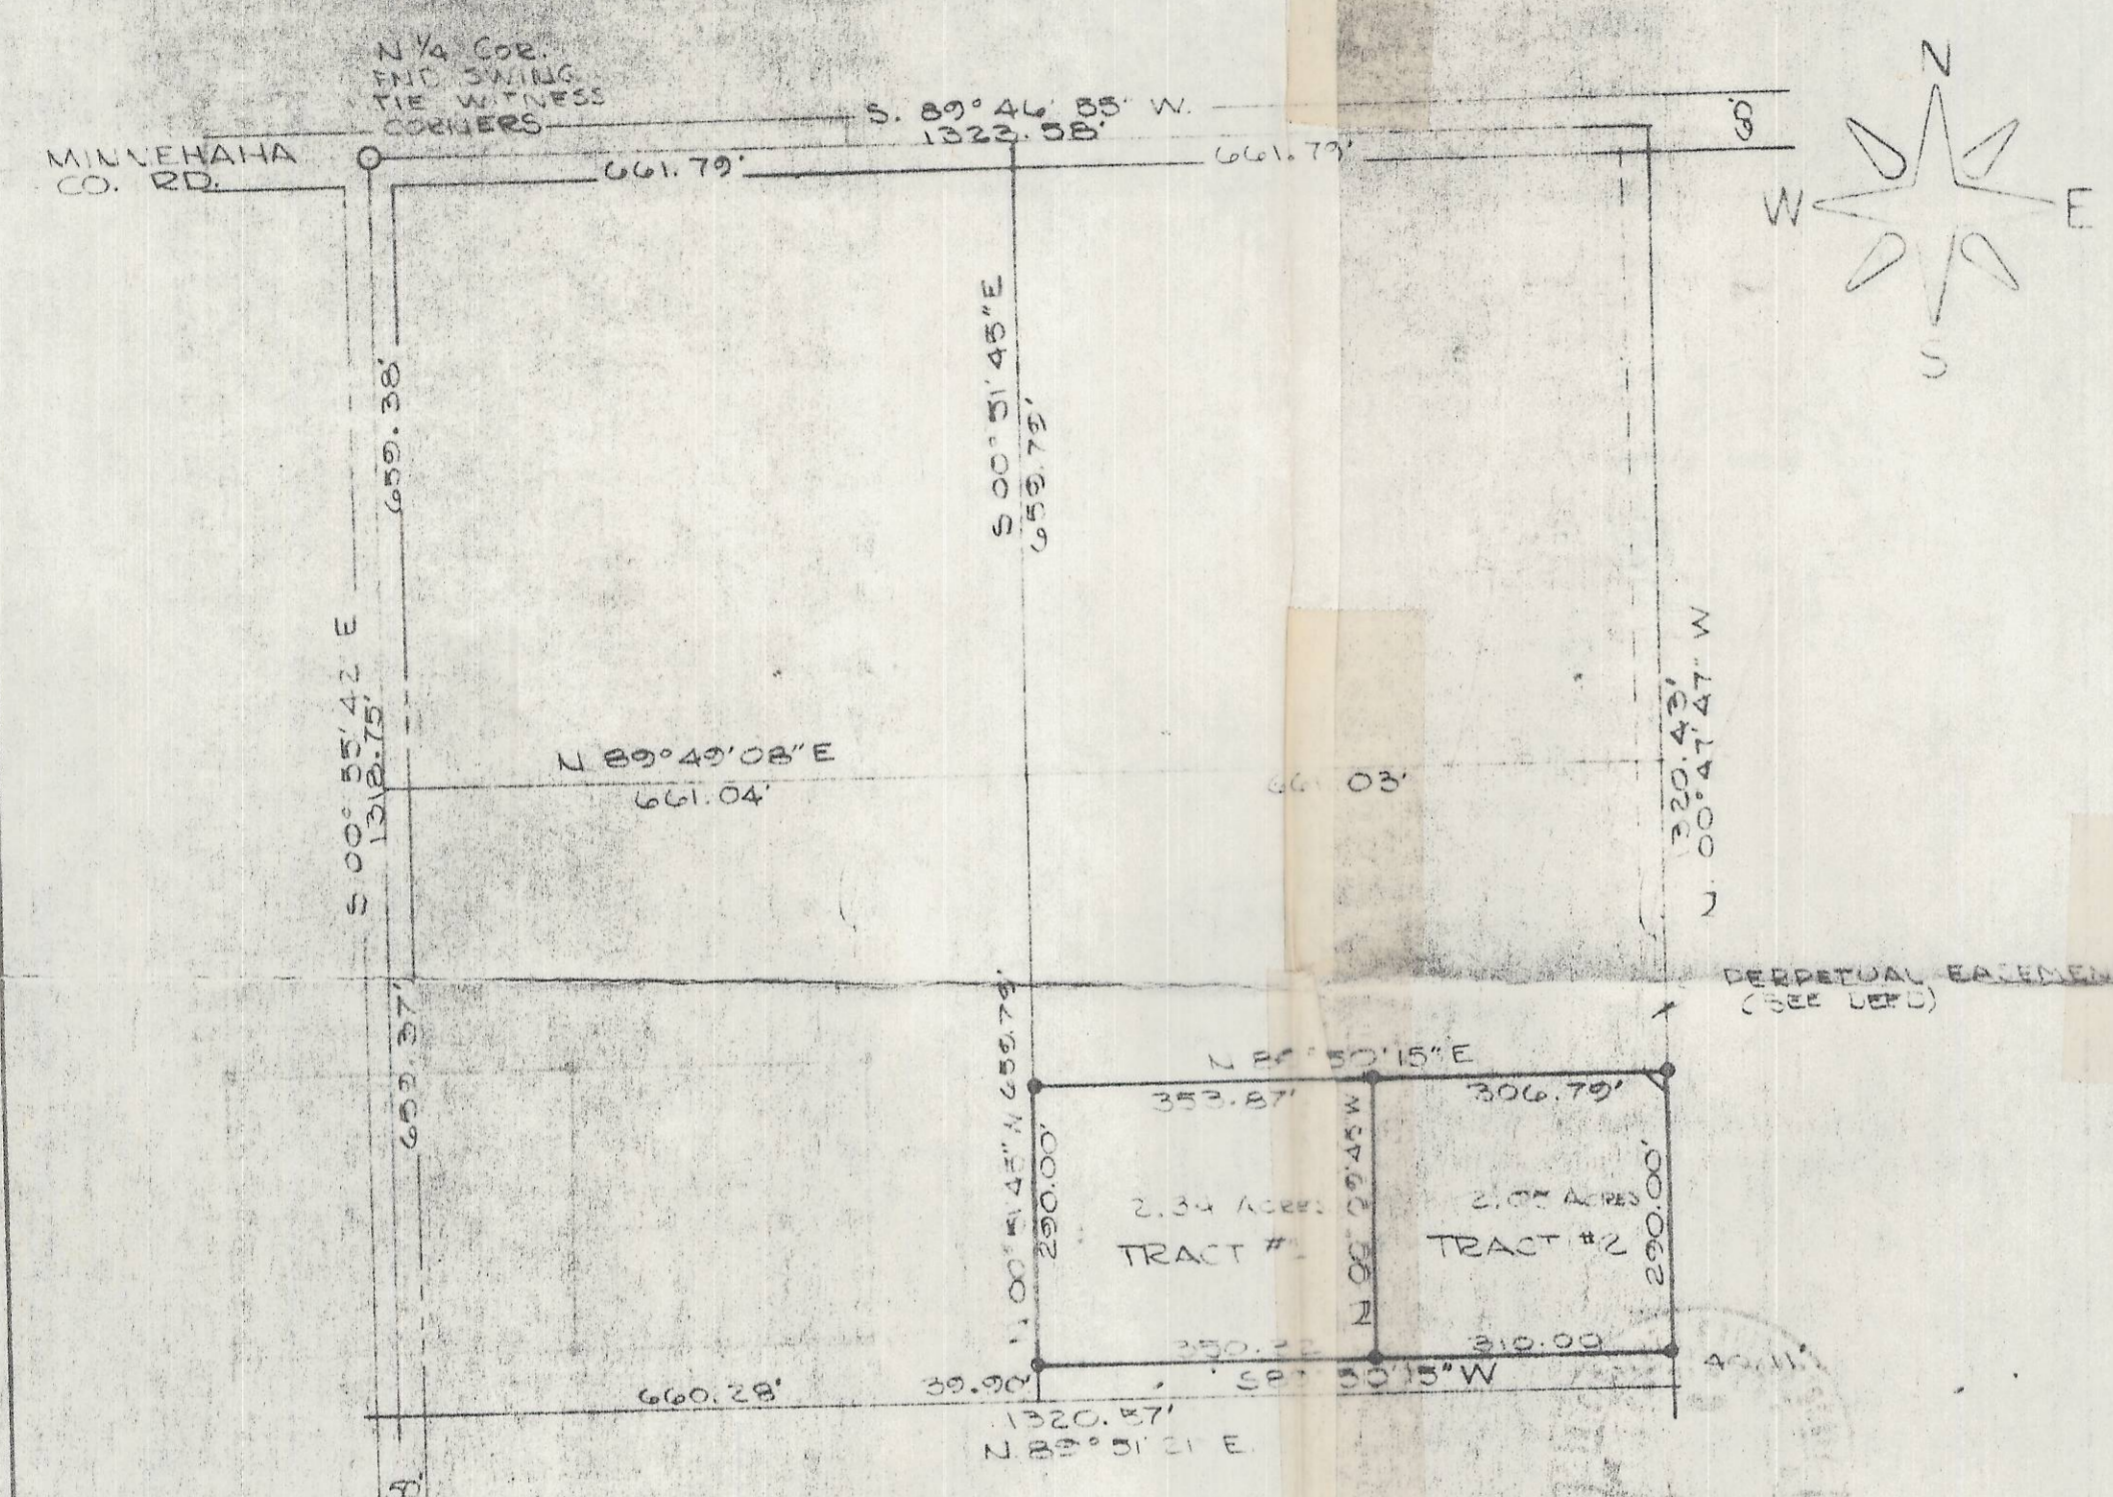

LEGEND

- 1/2" x 24" IRON PINS SET
- POINTS FND.


BEARINGS ARE OREGON STATE GRID BEARINGS AND ARE TIED TO USGS HERMISTON BUTTE.

ALL DISTANCES ARE TRUE

MEASUREMENTS AND ANGLES FOR SECTION 21 SUBDIVISION OBTAINED FROM UMATILLA COUNTY SURVEY RECORDS.

NW 1/4, NE 1/4 SECTION 21, T.4N., R. 28E. W.M.

CO. RD. NO. 704

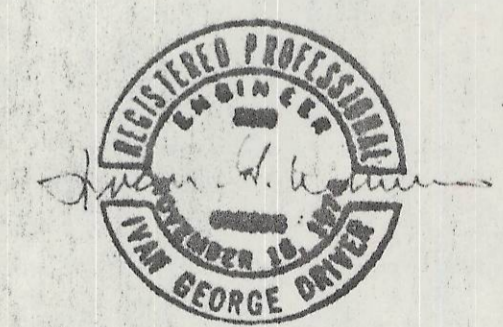

SURVEY FOR R.F. DANIEL					WAYNE HARRIS CO. INC.				
NW 1/4, NE 1/4 SECTION 21,					ENGINEERS - SURVEYORS PENDLETON, ORE				
T.4N., R. 28E. W.M.					SCALE	DATE	DWG	CHK	DWG. NO
					1" = 200'	3-3-77	I.D.	I.D.	77-2H