

Q-767-Ax


ELMO E. ROBNETT

Registered Land Surveyor

Box 0176
MILTON, OREGON



DESCRIPTIVE TRACTS
S.W. 1/4 OF N.E. 1/4 SEC. 16 T.5 N. R. 28 E.W.M.

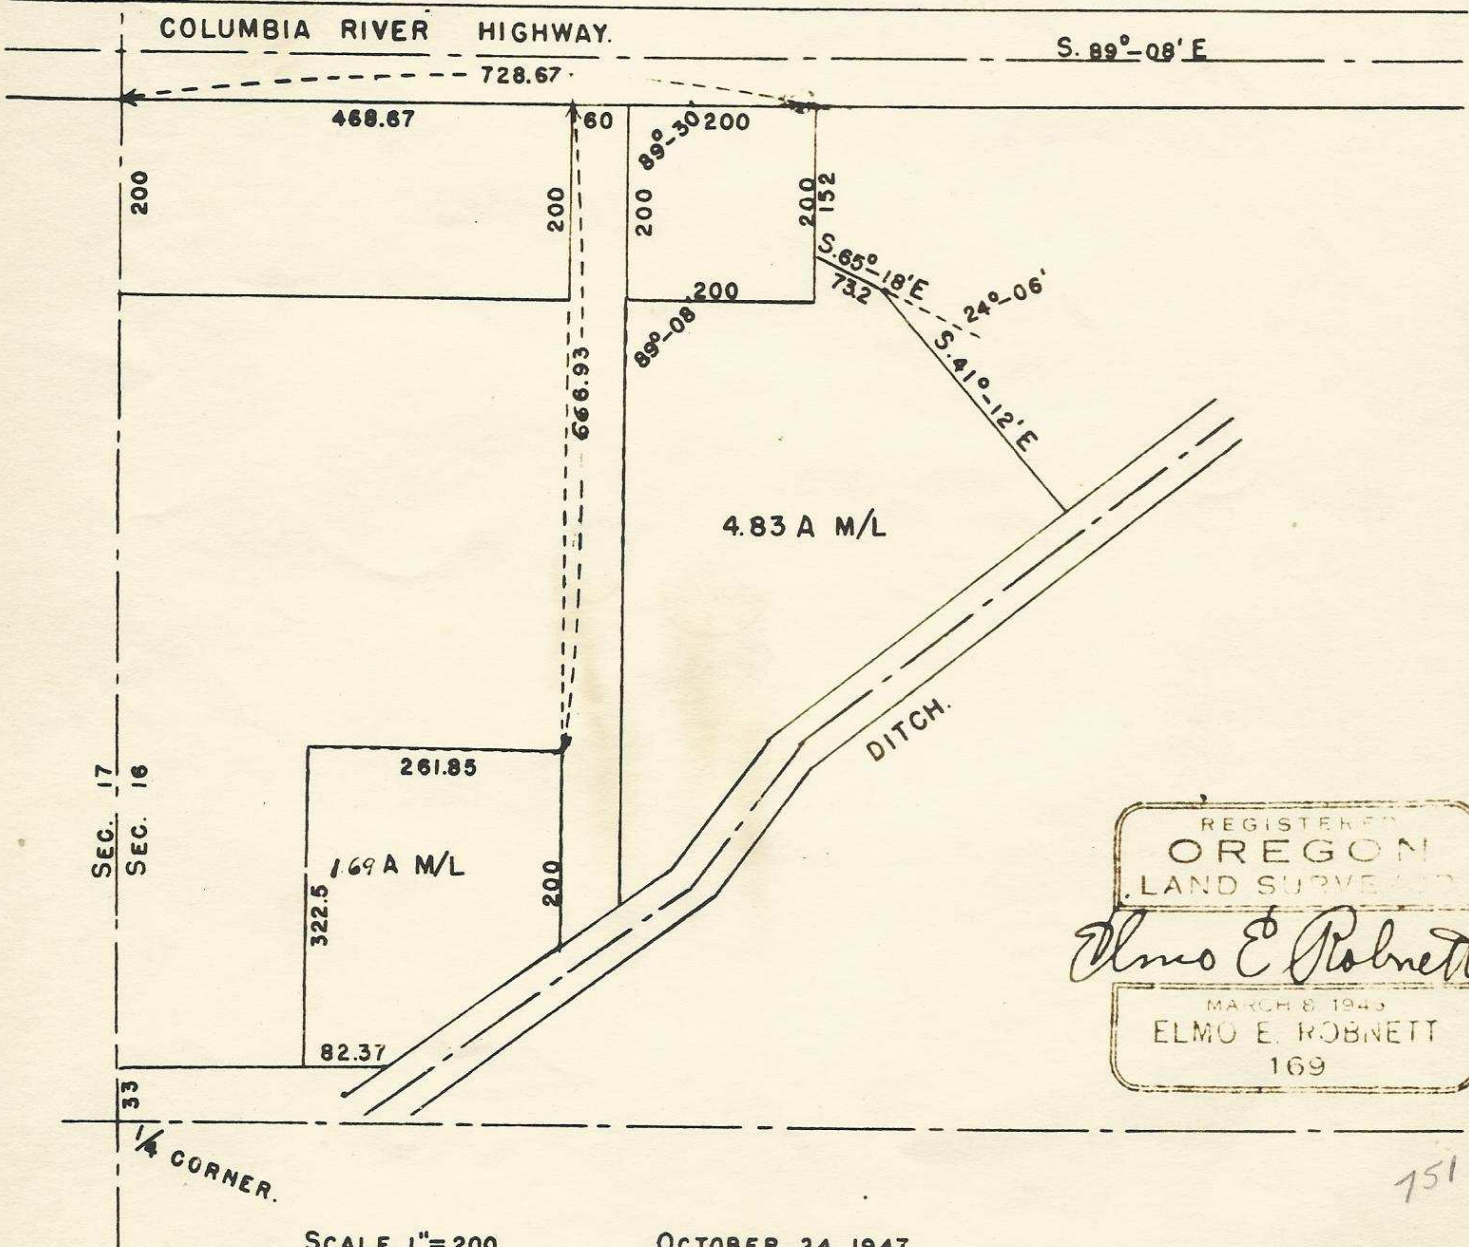

REGISTERED
OREGON
LAND SURVEYOR

Elmo E. Robnett

MARCH 8, 1943
ELMO E. ROBNETT
169

SCALE 1"=200

OCTOBER 24 1947

151