

State Line Road


Oregon - Washington State Line

10 30


10 30

89° 48' 50" 50 50


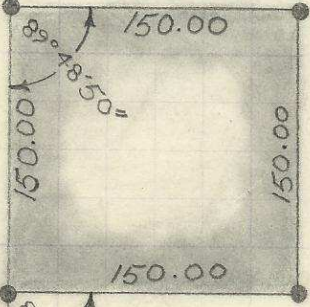

E State Hwy # 112

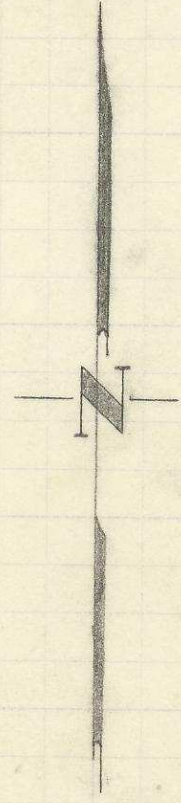

○ Iron Pins Found  
 ● Iron Pins Set  
 Lot 3, Grandview Orchard Tracts  
 Section 13, T. 6 N. R. 35. E. W. M.

50 50

S.H.R.W.

New Hwy.

60

REGISTERED  
**OREGON**  
 LAND SURVEYOR

*Ralph P. Thompson*

MAY 13, 1960  
 RALPH P. THOMPSON  
 506

Property Survey For  
 M.J. Kilburg  
 Milton-Freewater, Ore.

Date: 9/4/62 Scale: 1"=100'

Ralph P. Thompson  
 Land Surveying  
 Pendleton, Ore.

Q-821-Ay