

Q-872-A ✓

6N R35

NORTH-SOUTH CENTERLINE - PARTIAL SEC 13
1020.8 N

CENTER OF SEC 13

S 50°45'33" W 58.66'


OREGON-WASHINGTON STATE LINE

S 14°0' W 40.07'

S 34°32' W 172.96'

S 33°08' W 70.07'

S 16°44' W 81.75'

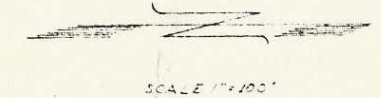

G. M. NEWBILL
LICENSED LAND SURVEYOR

17 N. Second Walla Walla, Wash. Phone 4170

Surveys	A SURVEY	
Descriptions	MCDONALD AGENT	
Sub Divisions	SECTION 13, TWP 6N, R35E, W1	
Date	8-2-50	No. 1756
Drawn By	GMN	
Checked By	GMN	