


Q-856-HX

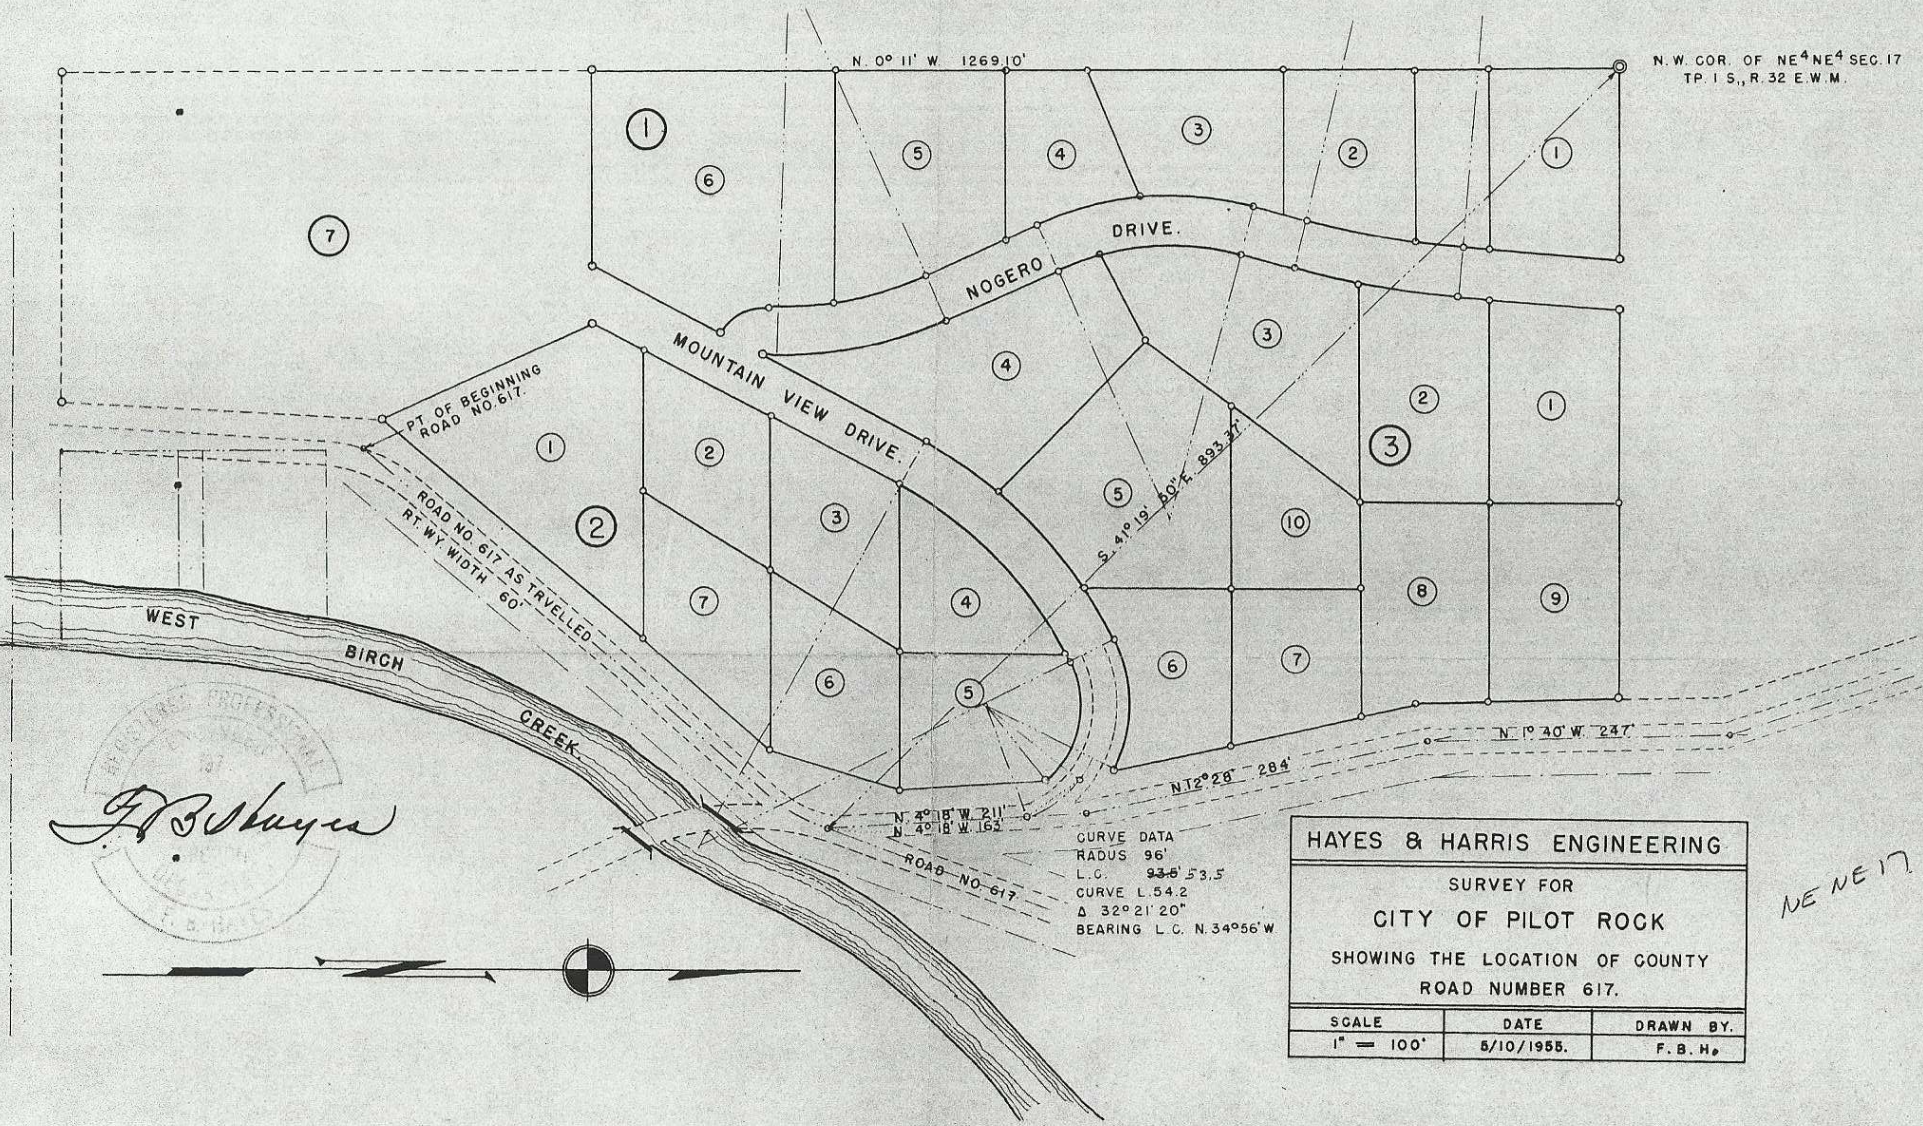

F. B. Hayes



HAYES & HARRIS ENGINEERING		
SURVEY FOR CITY OF PILOT ROCK		
SHOWING THE LOCATION OF COUNTY ROAD NUMBER 617.		
SCALE	DATE	DRAWN BY.
1" = 100'	5/10/1955.	F. B. H.

NE NE 17.