


Q-908-Ax

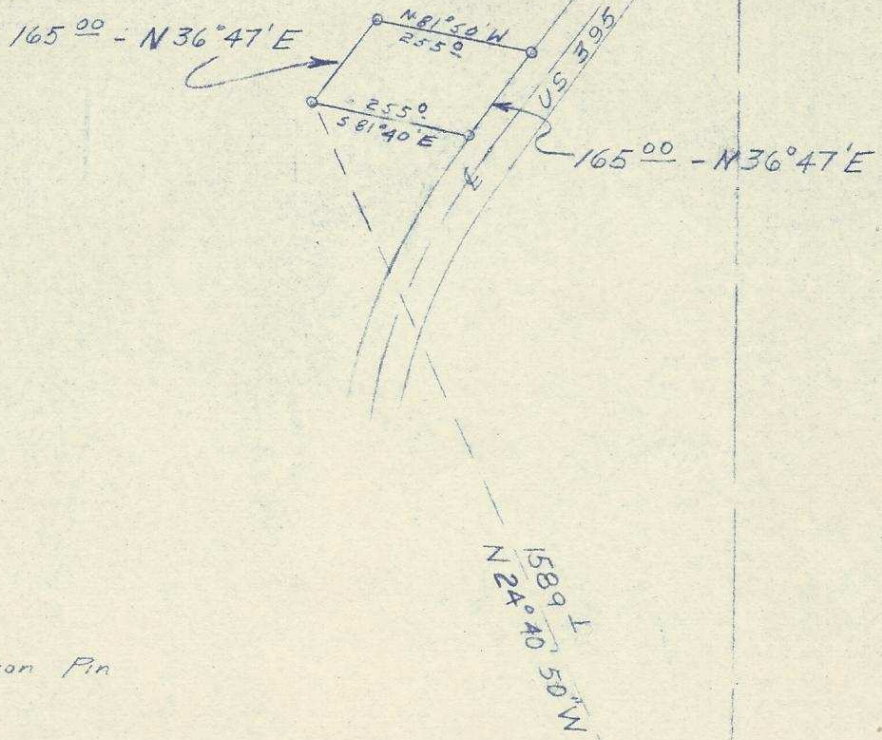

o Denotes 1/2" Iron Pin

REGISTERED  
OREGON  
LAND CONVEYOR

*Wayne O. Harris*

WAYNE O. HARRIS  
346

HAYES AND HARRIS

Survey For  
ALBERT J. DYER

Parcel in Section 28, T. 6 S.  
R. 31 E., W.M.

SCALE	DATE	DRN. BY	DRNG. NO.
1"=300'	4/27/61	L.H.A.	61-150