

SURVEY IN BLOCK 40, ORIGINAL TOWN OF FREEWATER  
 Surveyed for Melvin Daniels by Victor M. McLind

N. E. 5<sup>TH</sup> STREET

SCALE: 1" = 50"

MARCH, 1979

- — Indicates Set  
 3/4" x 30" Galv.  
 Iron Pipe

RECEIVED BY

Umatilla County Surveyor

Date April 19, 1979

Rec'd By MA


No. Q-934-AX

REGISTERED  
 PROFESSIONAL  
 LAND SURVEYOR

*Victor M. McLind*

OREGON  
 JULY 17, 1970  
 VICTOR M. McLIND  
 934

HAFFORD ST.

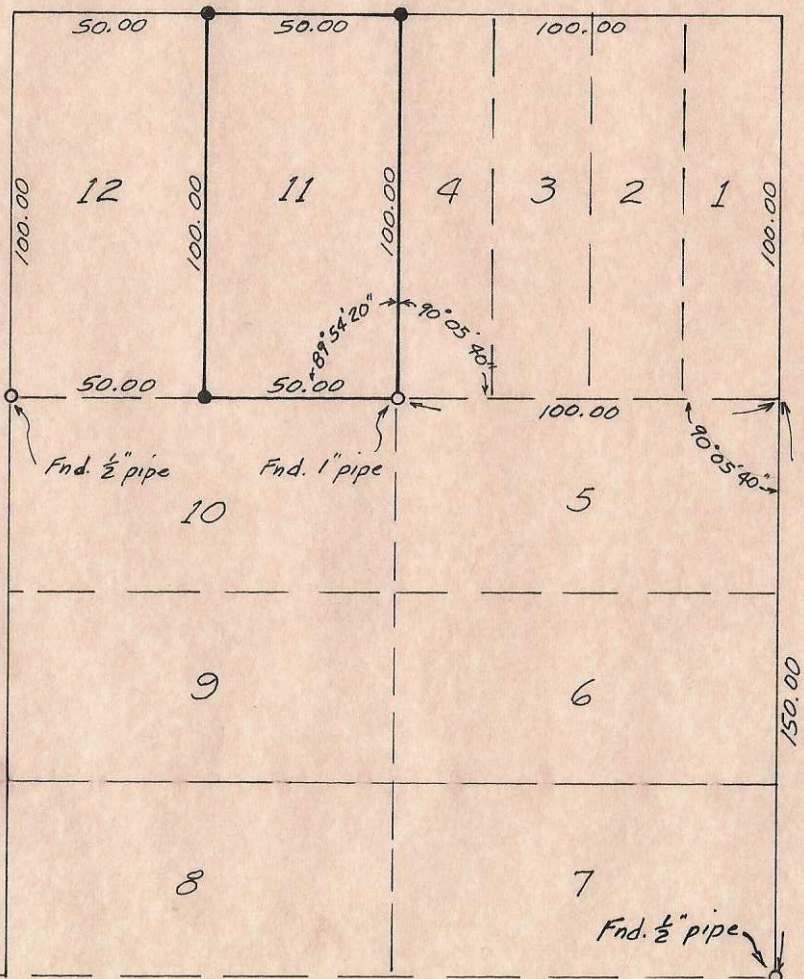

N. ELIZABETH ST.



Q-934-AX