


Q-993-AX

N.E. CORNER OF W 1/2 SW 1/4
SEC 1, TWP 5 N, R 35 E W.M.

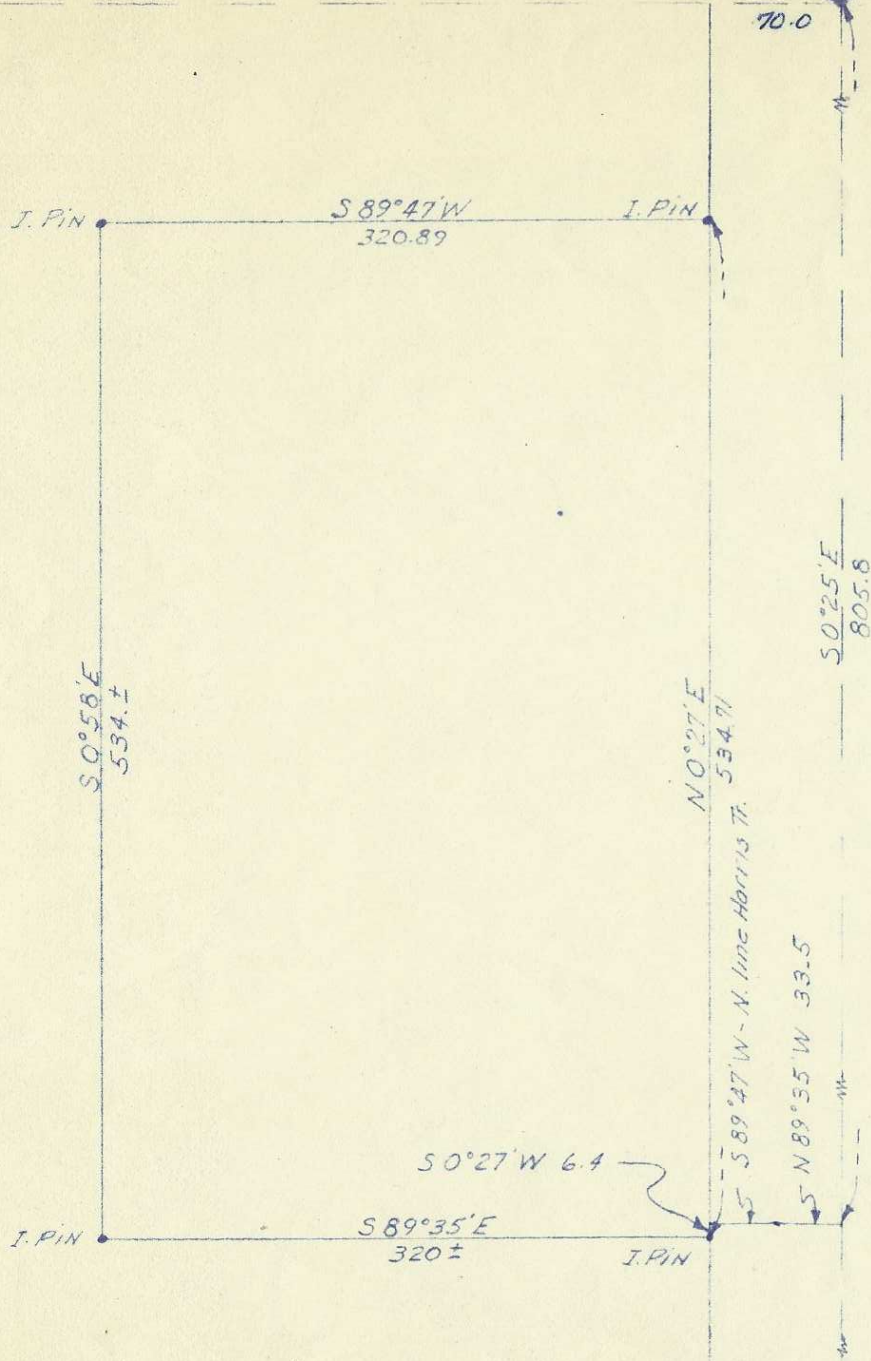

SCALE 1" = 100

SW 1

G. M. NEWBILL

LICENSED LAND SURVEYOR

17 N. Second

Walla Walla, Wash.

Phone 4170

Surveys
 Descriptions
 Sub Divisions

A SURVEY
 FOR
 WRINKLE REALTY 1039
 MILTON-FREEWATER, ORE.

Date 5-2-56
 Drawn By D.T.D.
 Checked By G.M.N.

No. 1782