
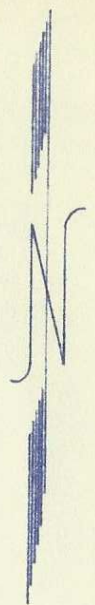


Q-1008-AX

5N35-2
DA

N.W. 1st ST

Mon.

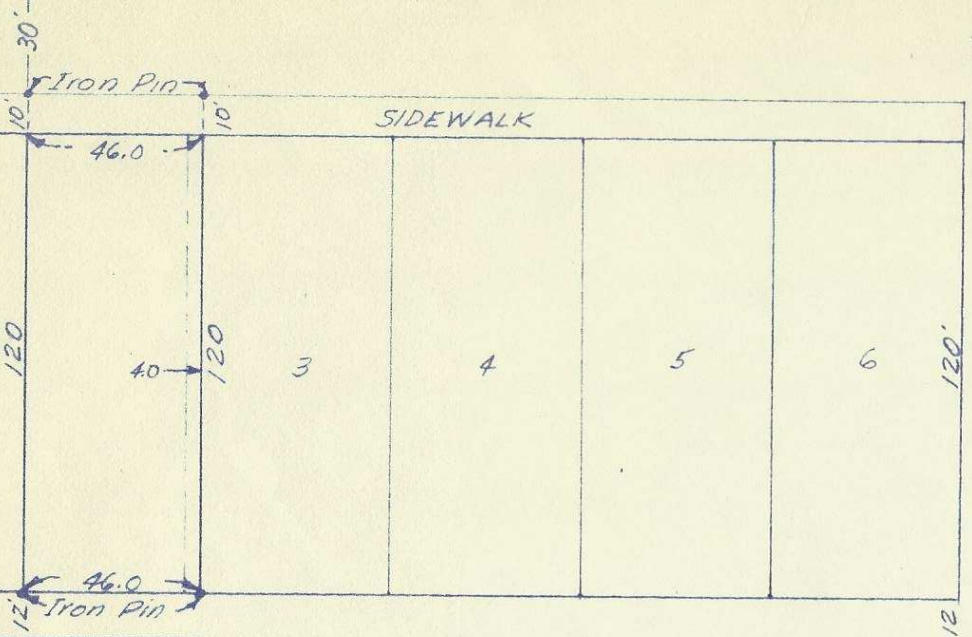

SCALE 1" = 50'

SE (2)

N MAIN

BROADWAY

Mon.

G. M. NEWBILL

LICENSED LAND SURVEYOR

17 N. Second

Walla Walla, Wash.

Phone 4170

Surveys

A SURVEY

Descriptions

FOR

S. A. HEMPE

Sub Divisions

117 N.W. 1ST ST. - MILTON-FREEWATER

Date

5-16-56

Drawn By

DTD

Checked By

G.M.N.

No.

1797 10²