


*Ernest Duncan*

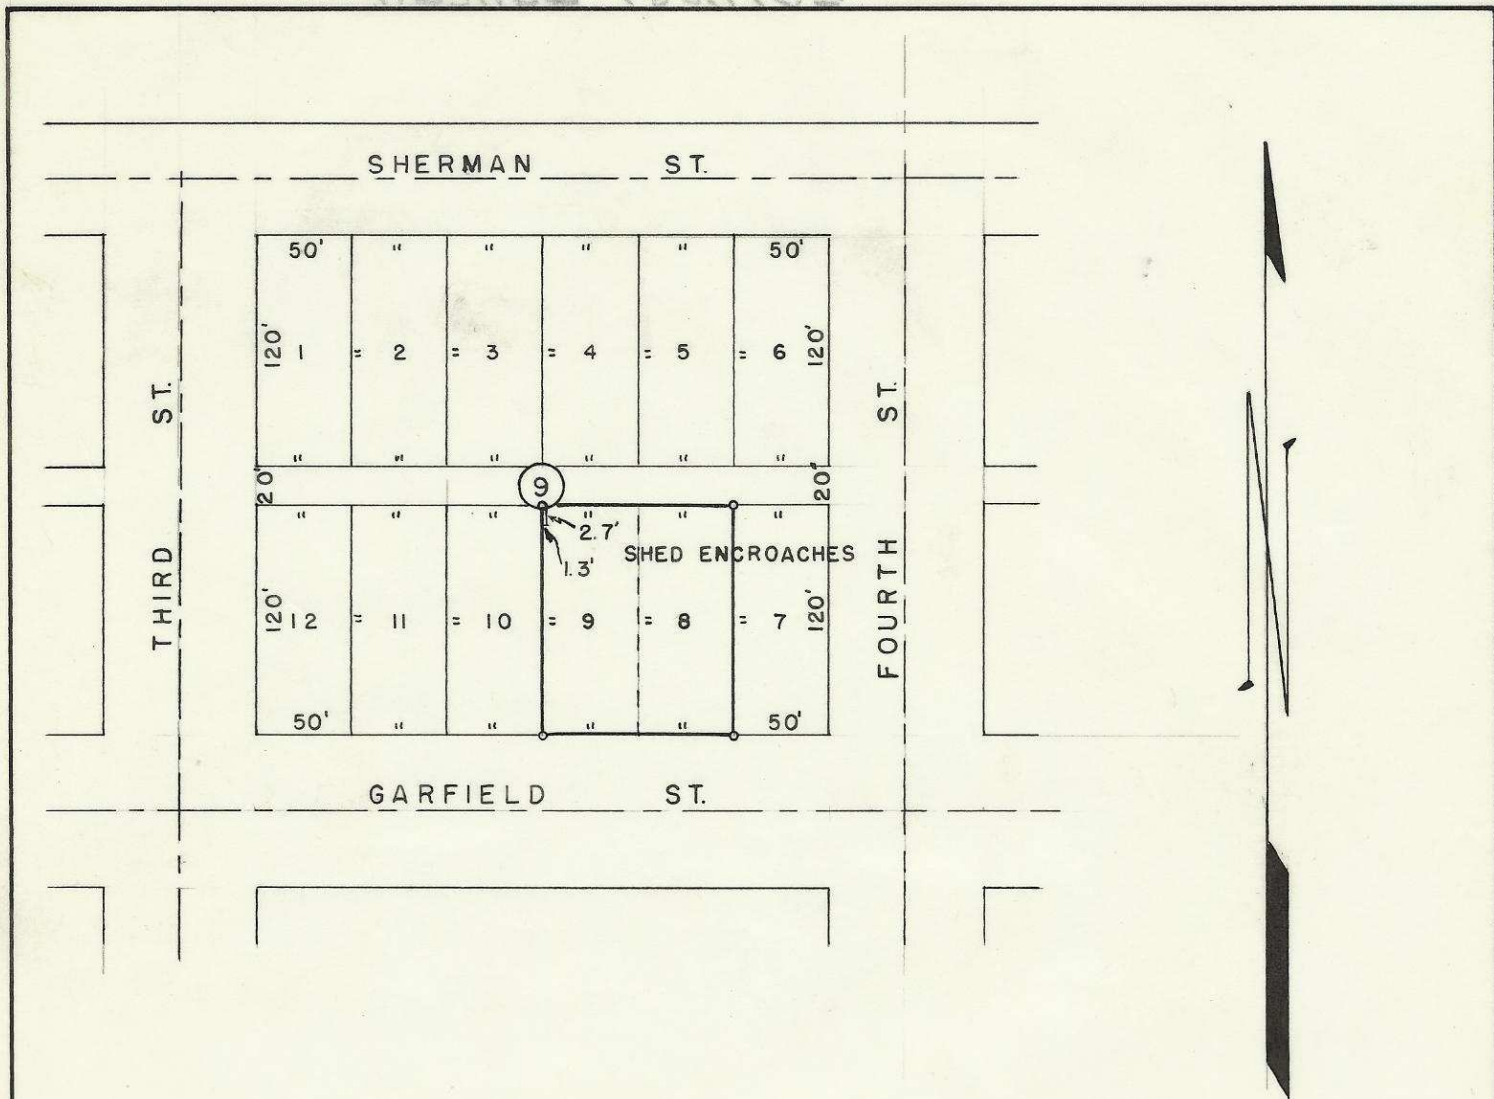

REGISTERED  
**OREGON**  
 LAND SURVEYOR

*Wayne O. Harris*

MAY 6, 1955  
 WAYNE O. HARRIS  
 346

*Q-1069-Ax*

**HAYES & HARRIS ENGINEERING**

SURVEY FOR  
**EARNEST DUNCAN**

LOTS 8 & 9, BLK. 9, RAILROAD ADD'N.  
 ATHENA, OREGON

*T4NR 35 Sec. 19 BA*

SCALE 1" = 100'	DATE 6-14-55	DRAWN BY W.O.H.
--------------------	-----------------	--------------------