


9-1071-AX

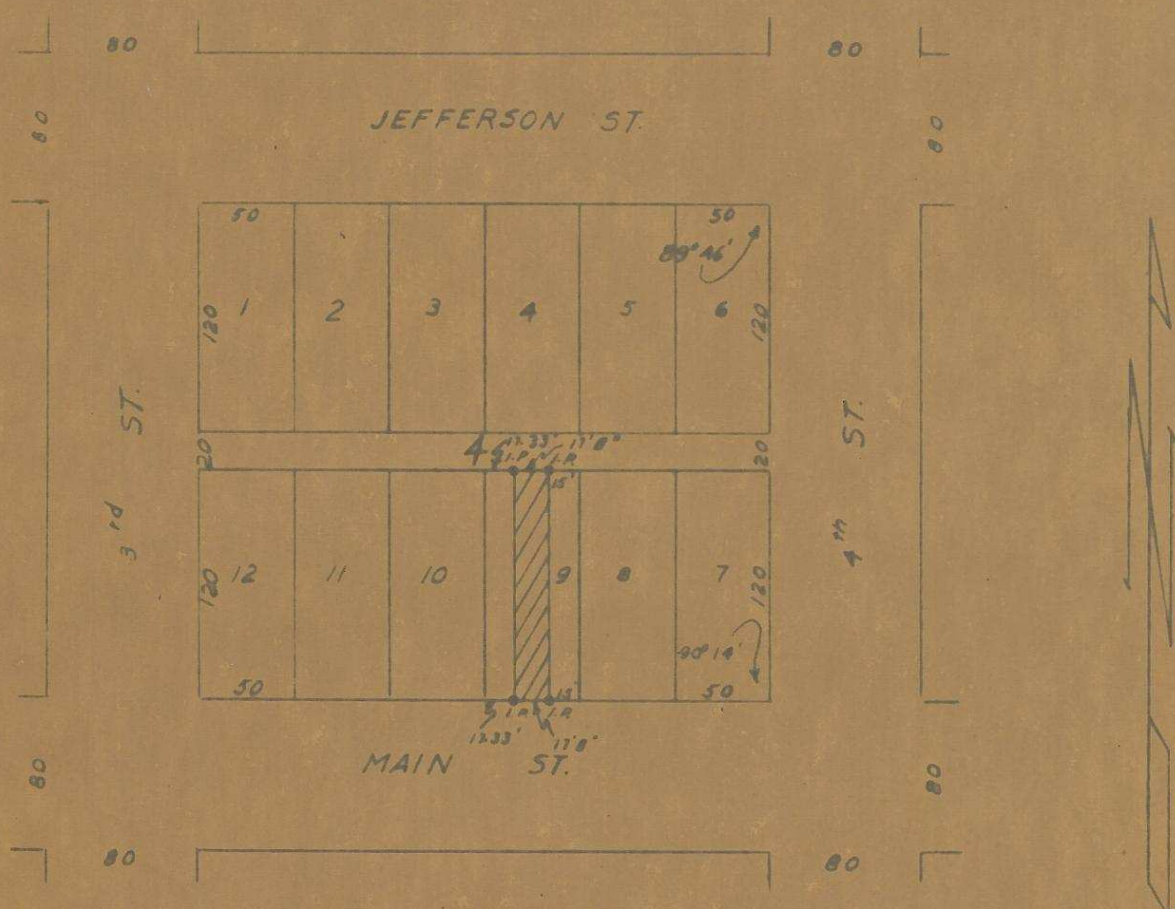

Wayne & Harris

HAYES AND HARRIS			
Survey For DEAN PINKERTON			
Parcel In Lot 9, Block 4 Original Town, Athena, Ore.			
Scale	Date	Drn. By	Drng. No.
1"-100'	11/2/58	WOH	58-72