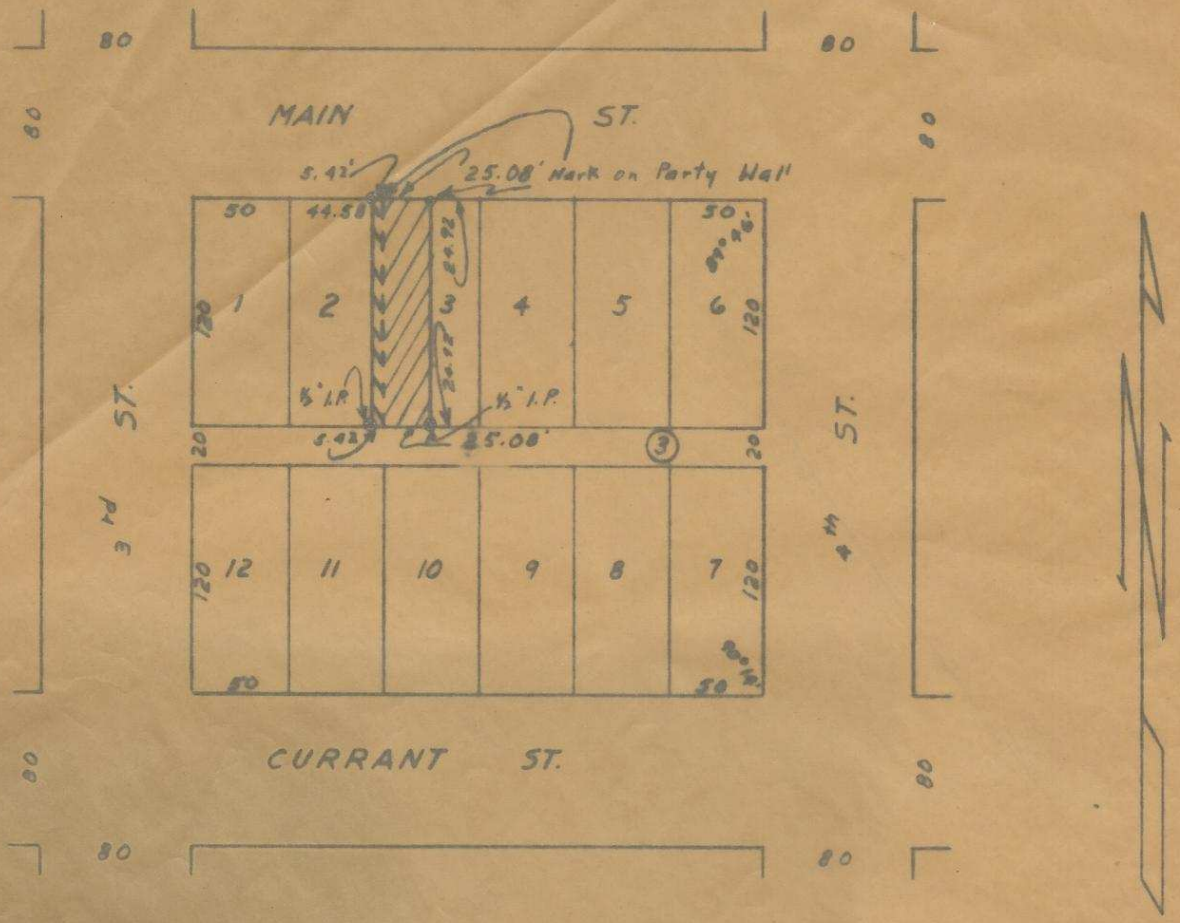

Wayne O. Harris

WAYNE O. HARRIS
OREGON
1946

HAYES AND HARRIS			
Survey For OLETA MILLER Parcel In Lots 2 & 3, Block 3 Original Town, Athena, Ore.			
Scale	Date	Drn. By	Drng. No.
1"-100'	9/14/59	WOH	59-97

G-1073-AX