


Q-1079-AX

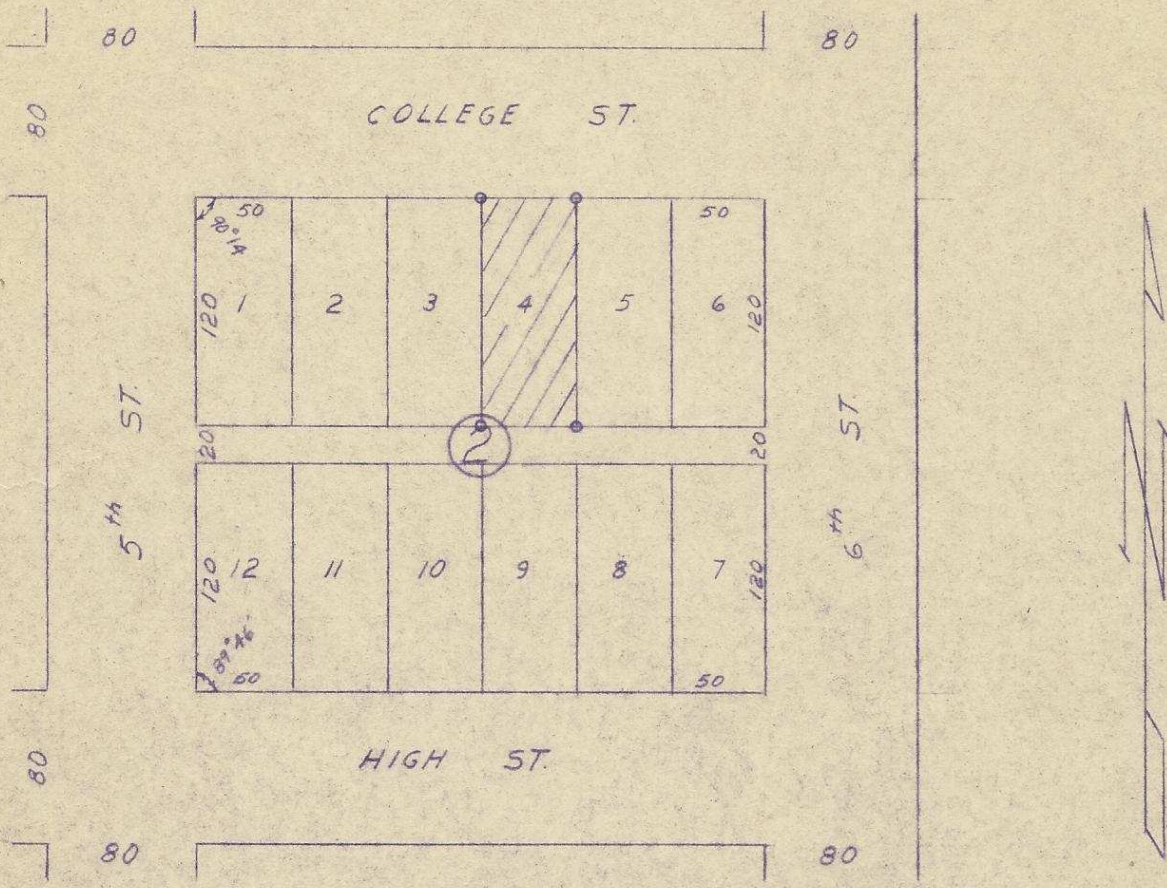

REGISTERED
OREGON
 LAND SURVEYOR

Wayne Q. Harris

MAY 6, 1955
WAYNE Q. HARRIS
346

| | | | |
|----------------------------------|---------|---------|-----------|
| HAYES AND HARRIS | | | |
| Survey For ARTHUR BUSH | | | |
| Lot 4 | | Block 2 | |
| Kirk's 4th Add'n To Athena, Ore. | | | |
| Scale | Date | Drn. By | Drng. No. |
| 1"=100' | 10/6/59 | WOH | 59-98 |