
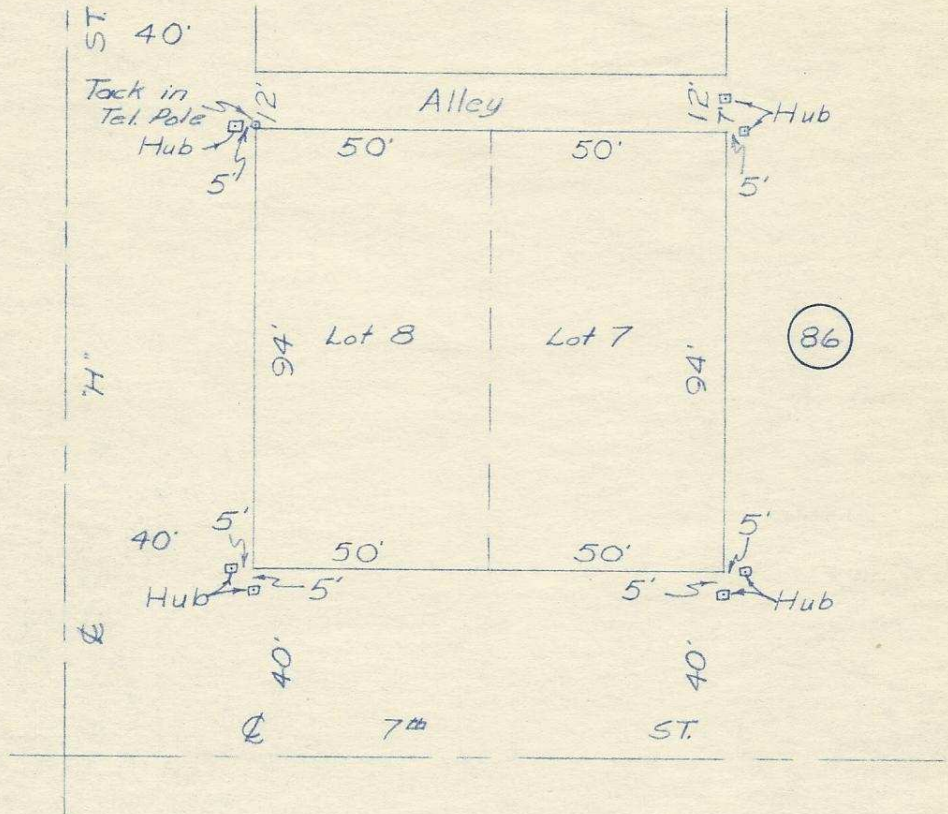


Q-1086-AX

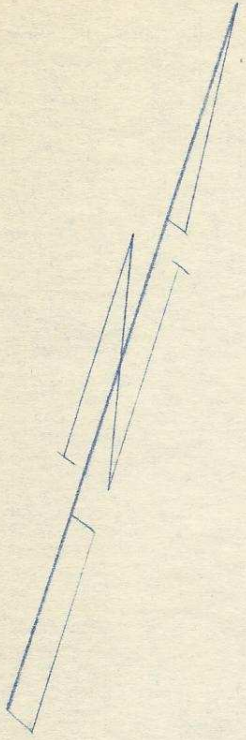

REGISTERED
OREGON
 LAND SURVEYOR

Wayne O. Harris
 MAY 6, 1955
 WAYNE O. HARRIS
 346

HAYES AND HARRIS			
SURVEY FOR			
CARL GOLDE			
LOTS 7 & 8		BLOCK 86	
WARDWELLS		ADDITION	
UMATILLA,		OREGON	
560			
SCALE	DATE	DRN. BY	DRNG. NO
1"-40'	8/7/60	T.F.	60-134