


② - 1096 - AX

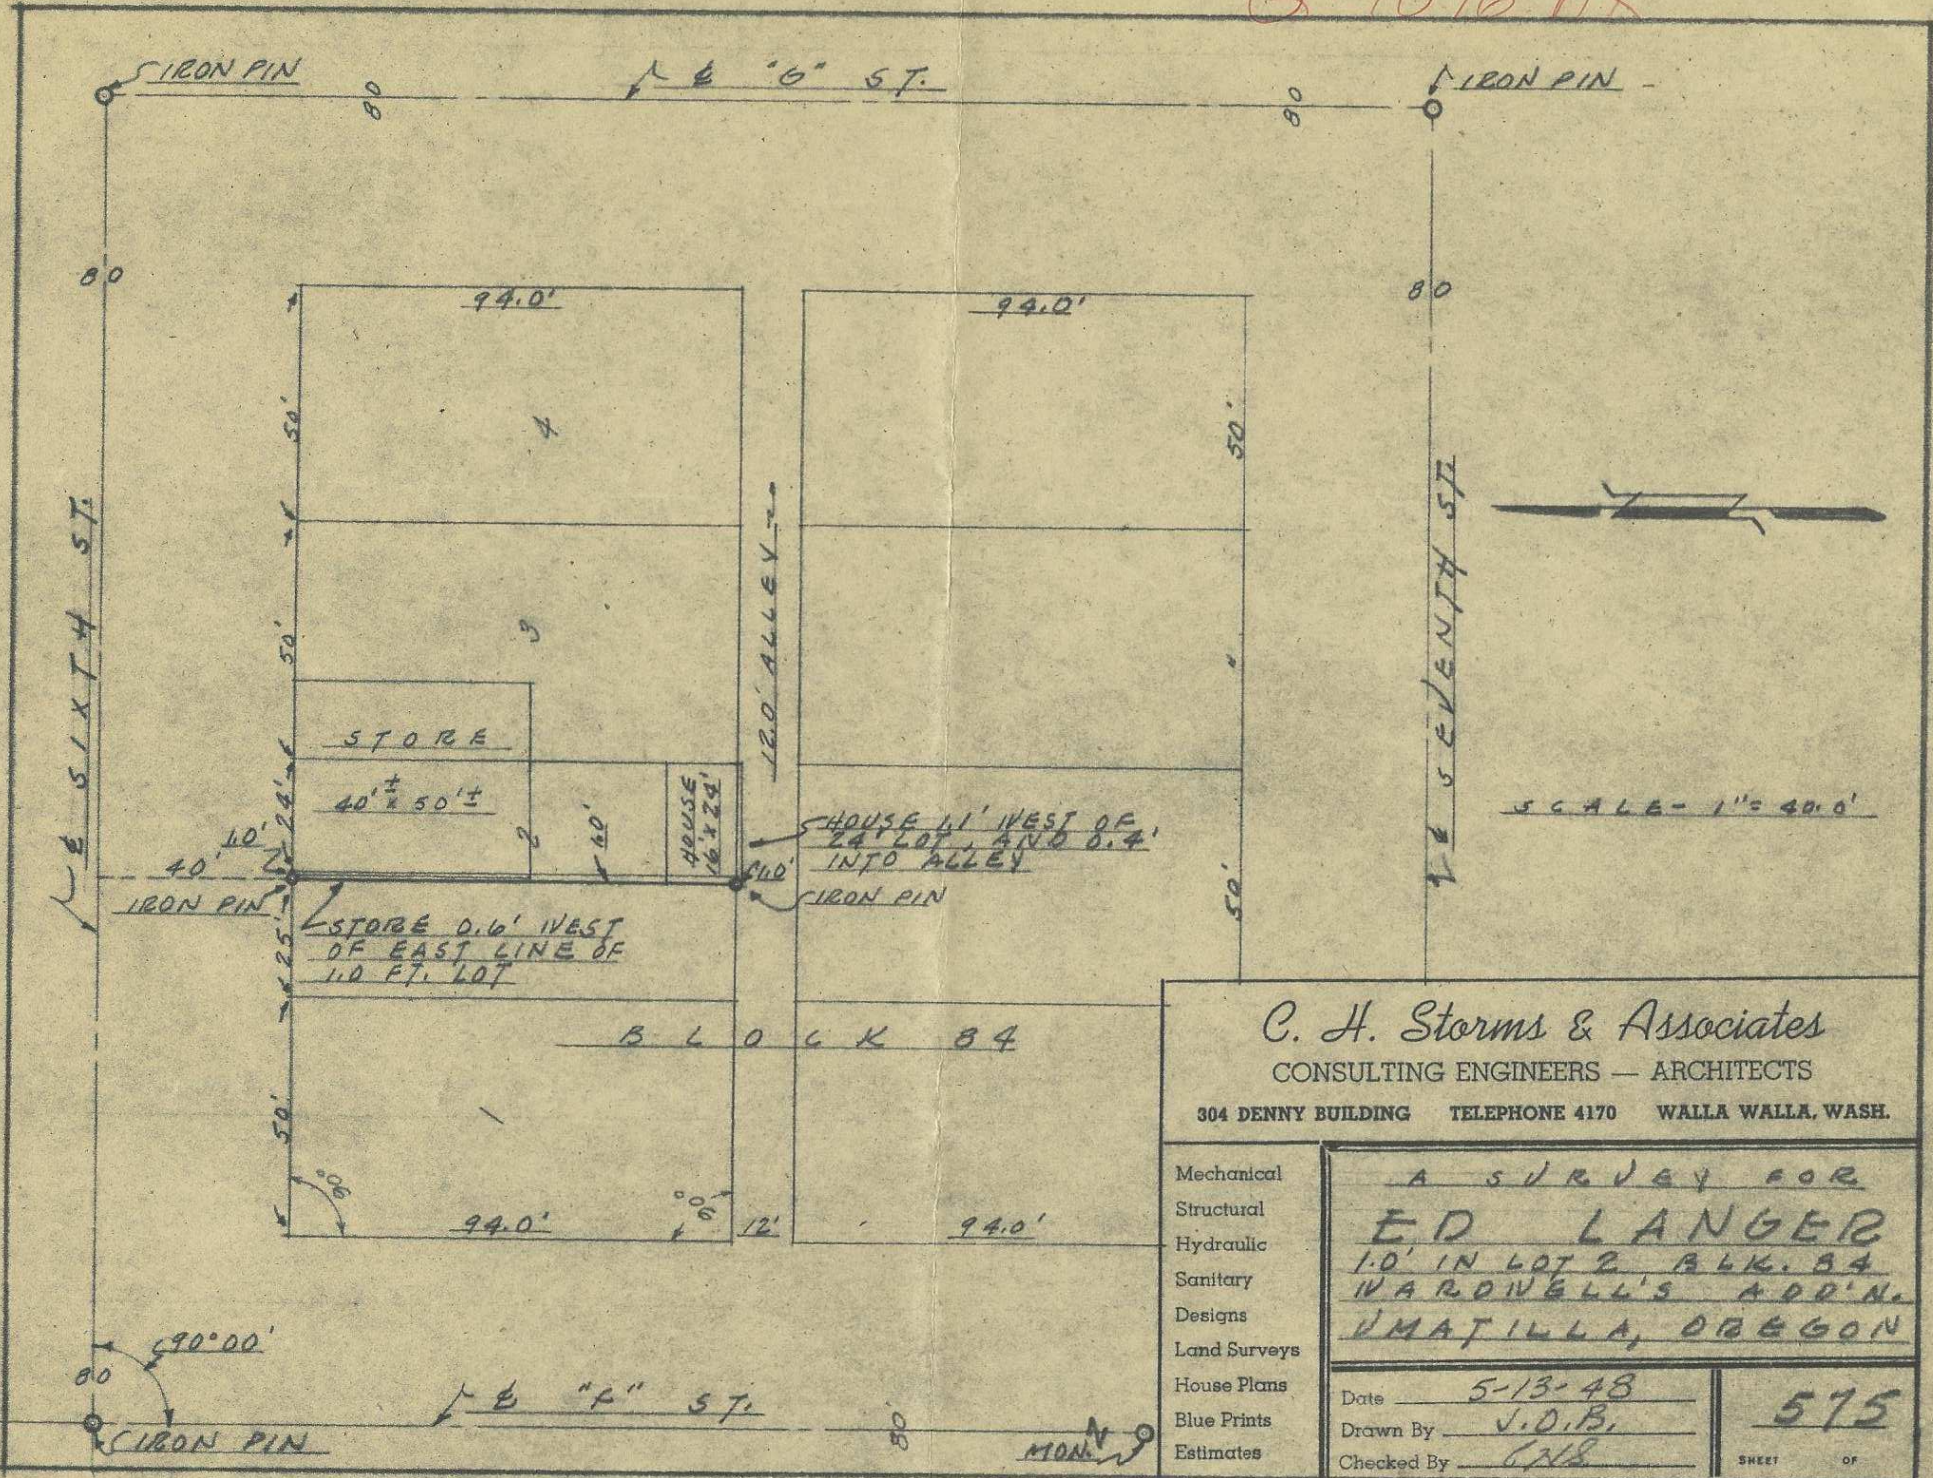

C. H. Storms & Associates

CONSULTING ENGINEERS — ARCHITECTS

304 DENNY BUILDING TELEPHONE 4170 WALLA WALLA, WASH.

- Mechanical
- Structural
- Hydraulic
- Sanitary
- Designs
- Land Surveys
- House Plans
- Blue Prints
- Estimates

A SURVEY FOR  
**ED LANGER**  
 1.0' IN LOT 2 BLK. 34  
 WARDWELL'S ADD'N.  
 UMATILLA, OREGON

Date 5-13-48  
 Drawn By J.O.B.  
 Checked By C.N.S.

**575**  
 SHEET OF