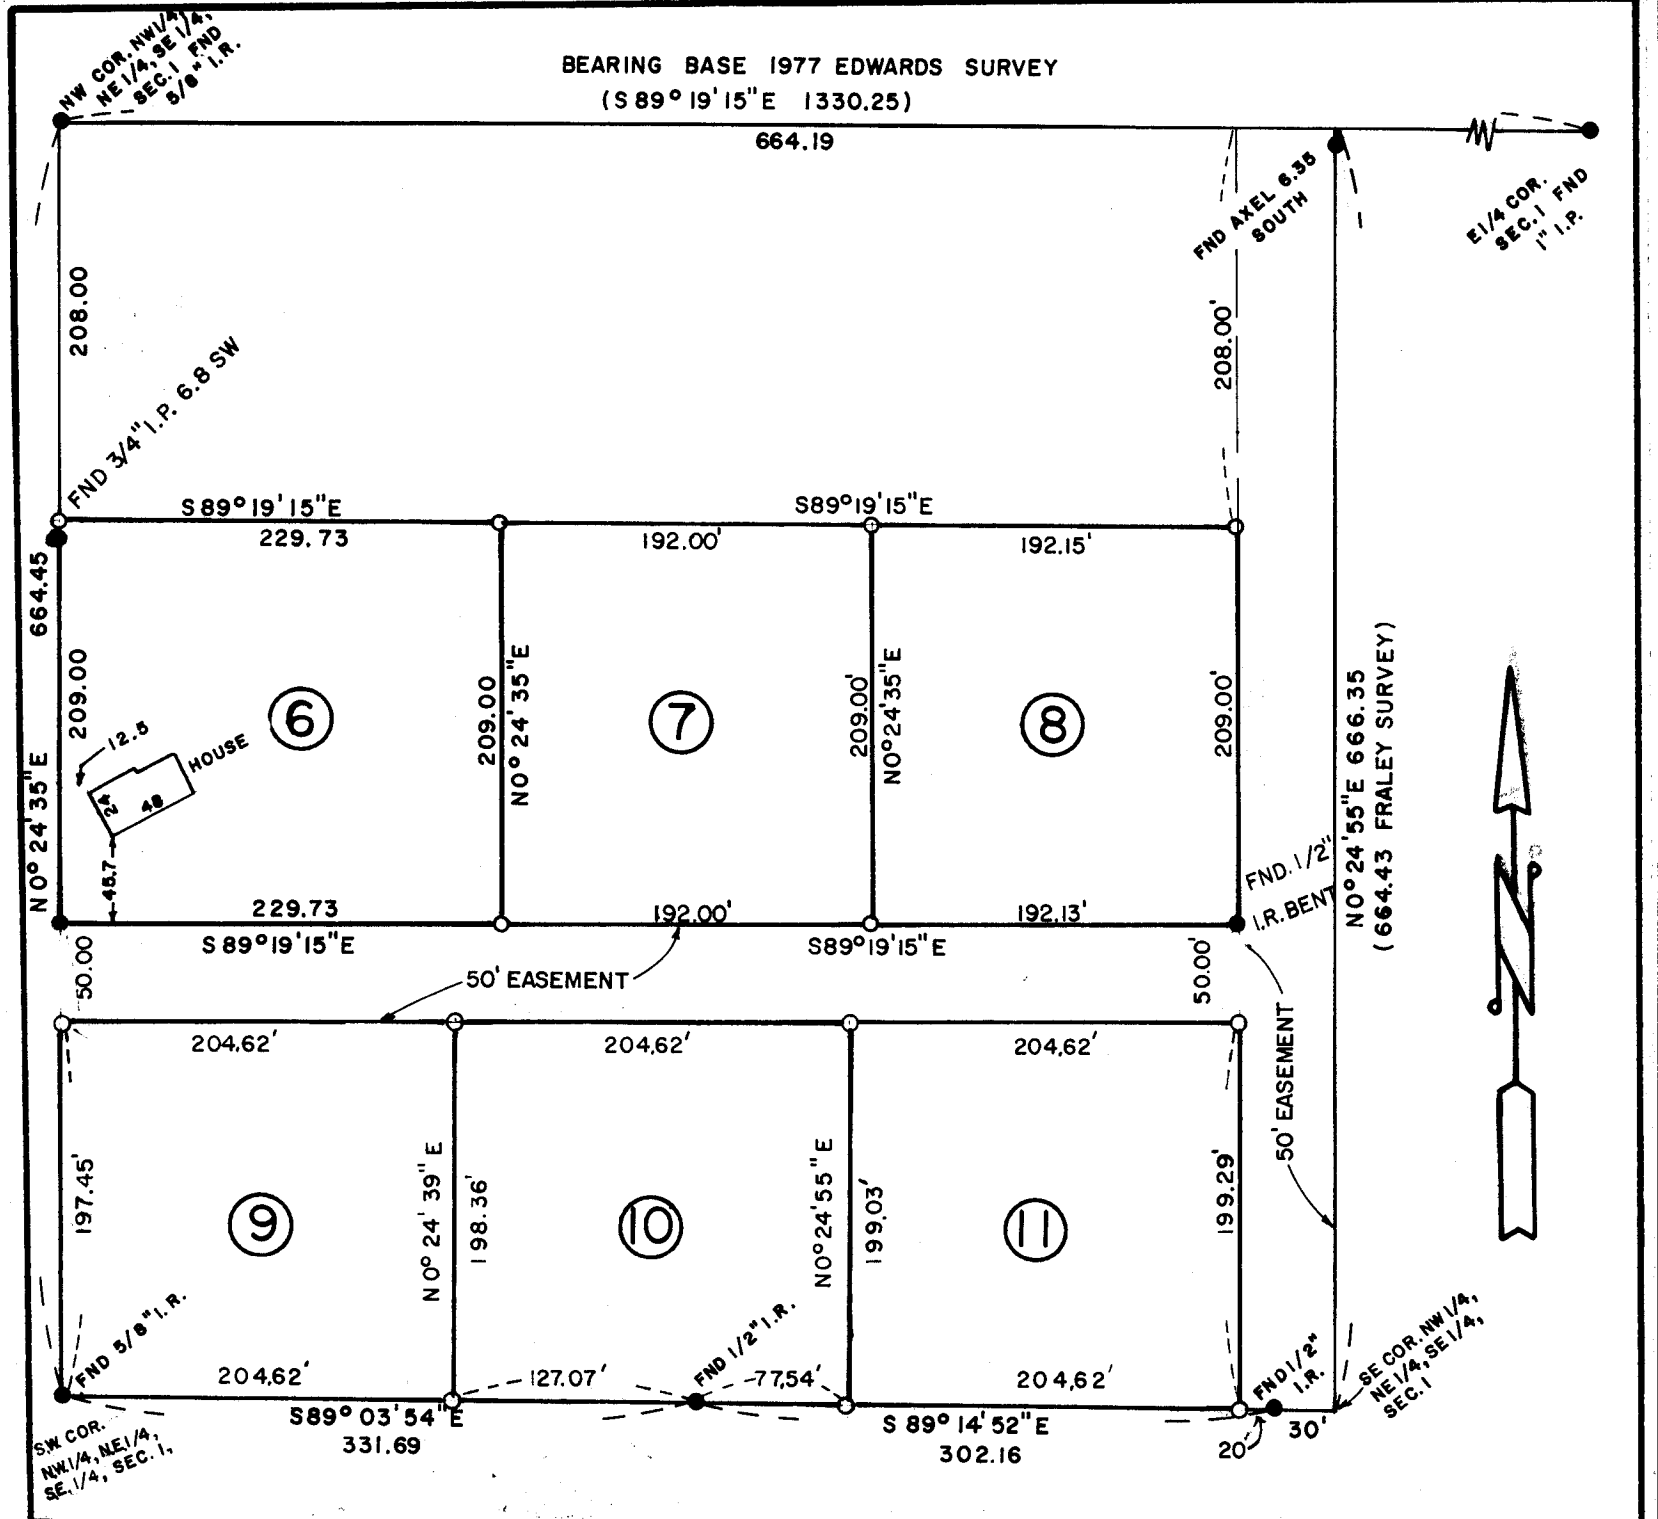

SURVEY FOR BILL ROFF

LOCATION SE 1/4

SEC. 1 , T 4 N, R 28 E, W.M., UMATILLA COUNTY, OREGON

DATE 4-10-78 REVISED 2-1-79
2nd RIVISION 8-15-79

SCALE: 1"=100'

●MONUMENTS FOUND

(000) OF RECORD

OIRON RODS SET 1/2"

JOB NO. S7803097

Q-1178-AX

REGISTERED PROFESSIONAL LAND SURVEYOR

G. Dennis Edwards

OREGON
JULY 16, 1971
G. DENNIS EDWARDS
951

EDWARDS SURVEYING
567-3336

P. O. Box 763
Hermiston, Ore.